


T.26S.R.13W.W.M.

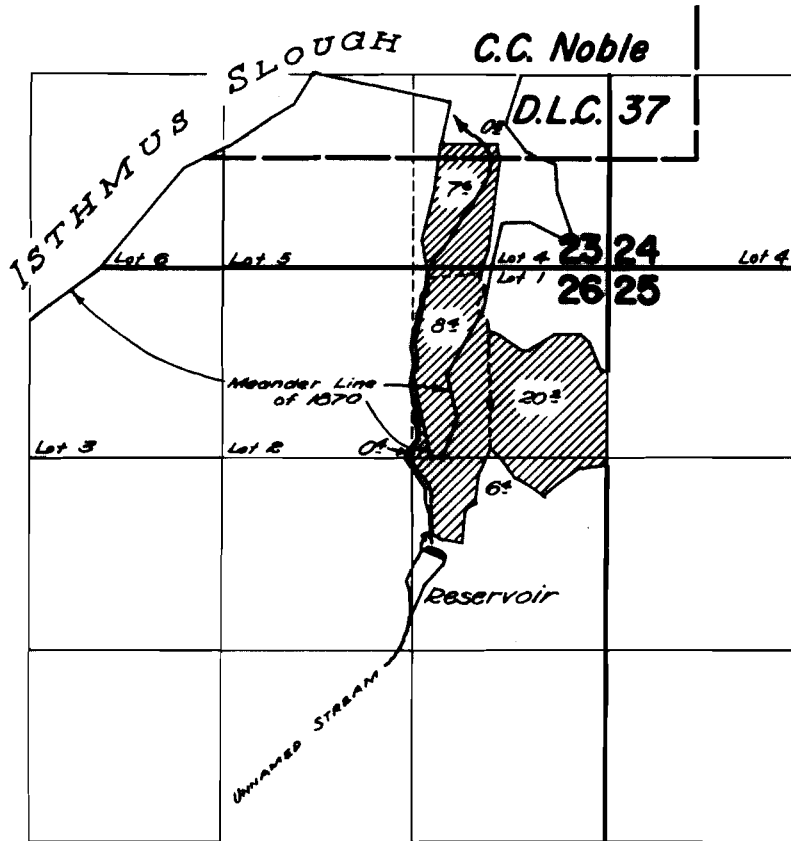

**FINAL PROOF SURVEY**  
UNDER

R-27314                      R-1373  
Application No. 27315    Permit No. 21477  
IN NAME OF

JAMES A. LYONS

Surveyed Aug. 2 & 3 1961, by C.O. Bartels.