


T.26S.R.13W.W.M.

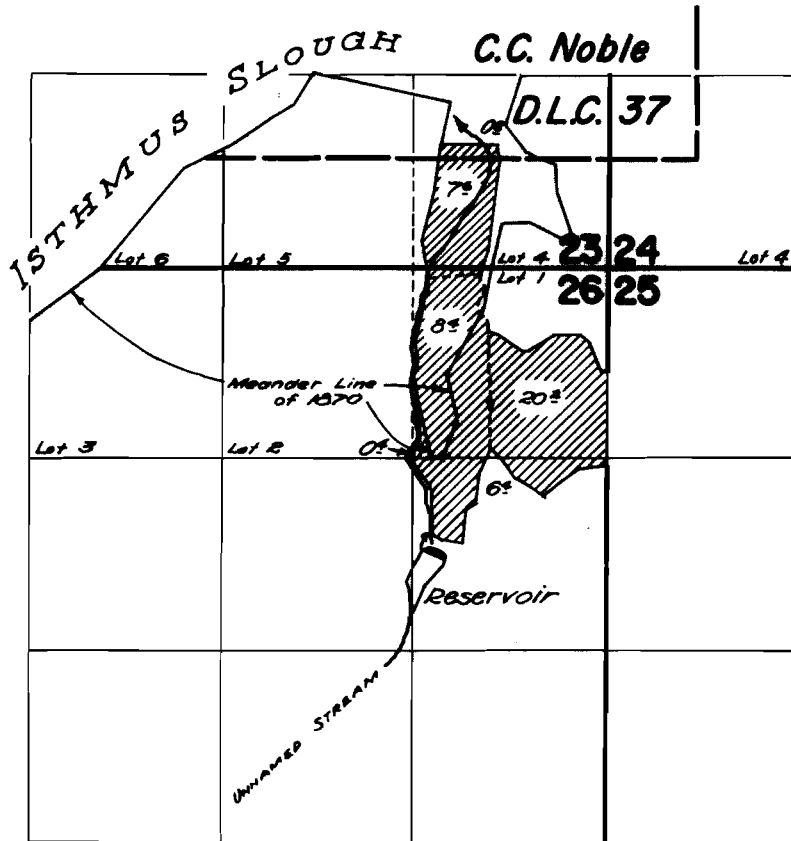

FINAL PROOF SURVEY
UNDER

R-27314 R-1373
Application No. 27315 Permit No. 21477
IN NAME OF

JAMES A. LYONS

Surveyed Aug. 2 & 3 1961, by C.O. Bartels.