


T.24S.R.13W.W.M.

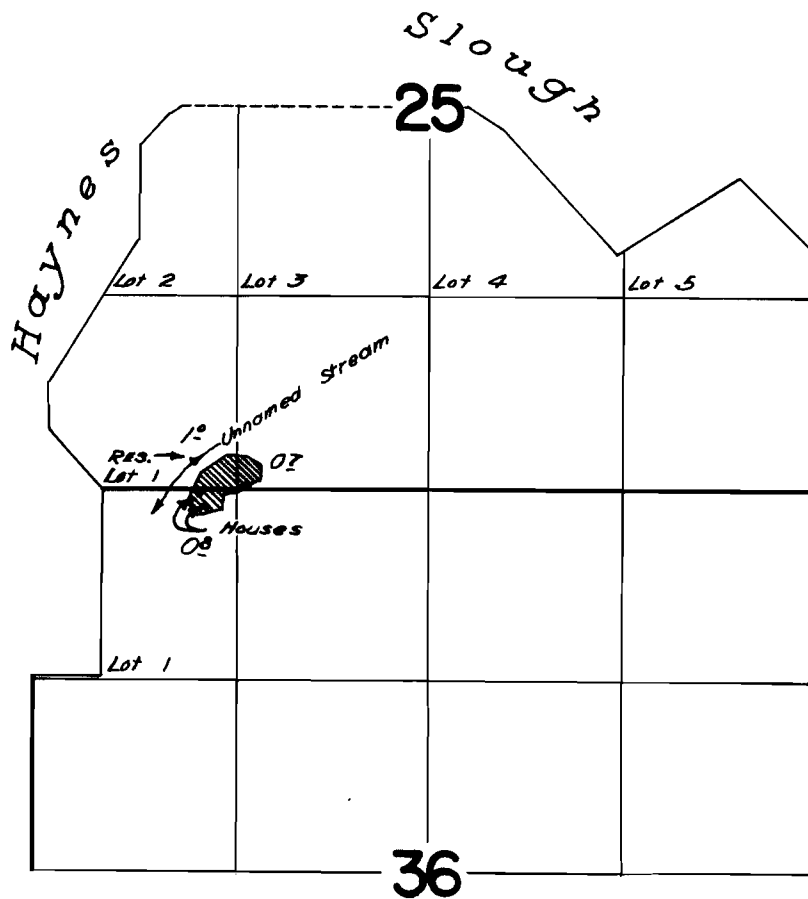

FINAL PROOF SURVEY UNDER

R-30482 R-1825
Application No. 30256 Permit No. 23968
IN NAME OF

ANDREW KERMIT ANDERSON

Surveyed *August 9 1961*, by *C.O. Bartels*