


T.24S.R.13W.W.M.

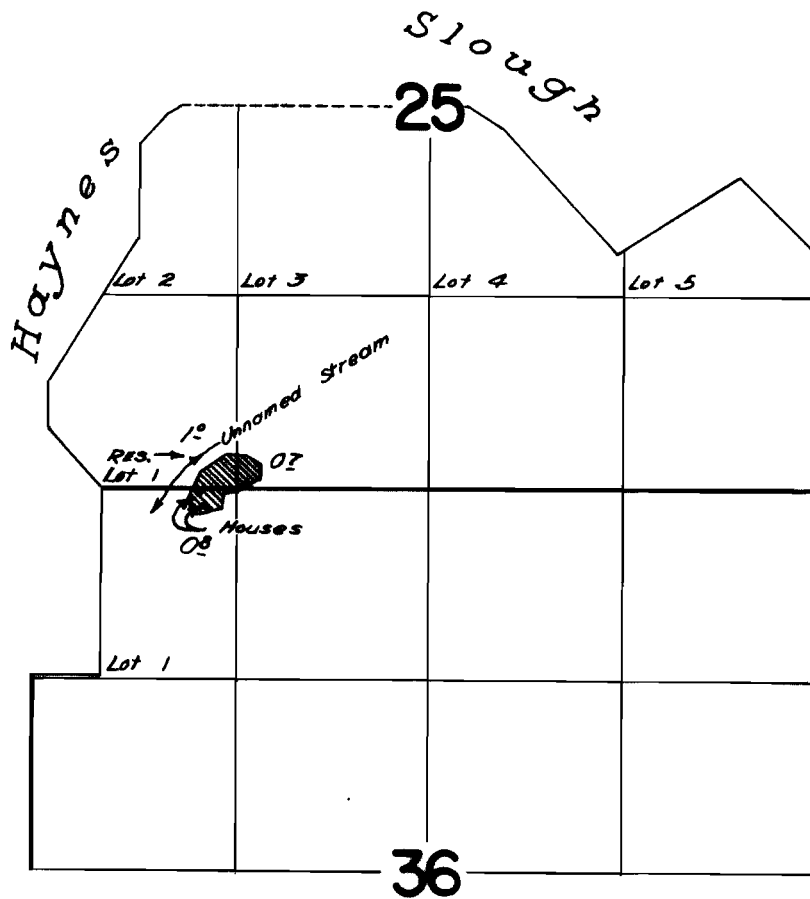


FINAL PROOF SURVEY
UNDER

R-30482 R-1825
Application No. ~~30256~~ Permit No. 23968...
IN NAME OF

ANDREW KERMIT ANDERSON

Surveyed August 9 1961, by G.O. Bartels...

T.24S.R.13W.W.M.

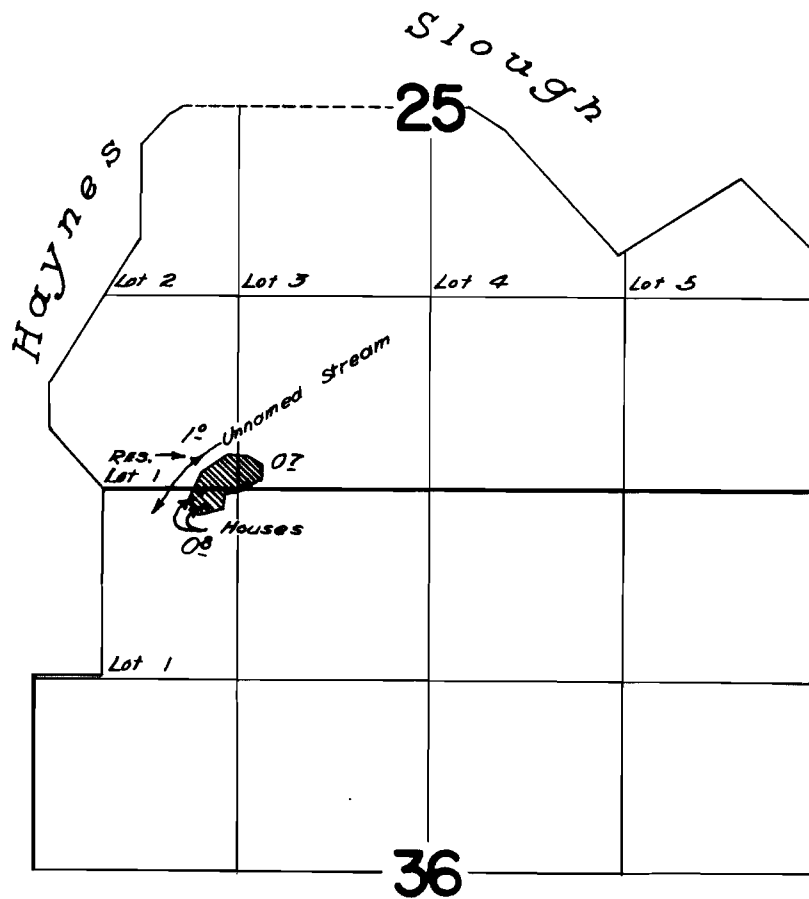

FINAL PROOF SURVEY
UNDER

R-30482 R-1825
Application No. 30256 Permit No. 23968
IN NAME OF

ANDREW KERMIT ANDERSON

Surveyed *August 9 1961*, by *G.O. Bartels*