


T.28 S.R.12 W.W.M.

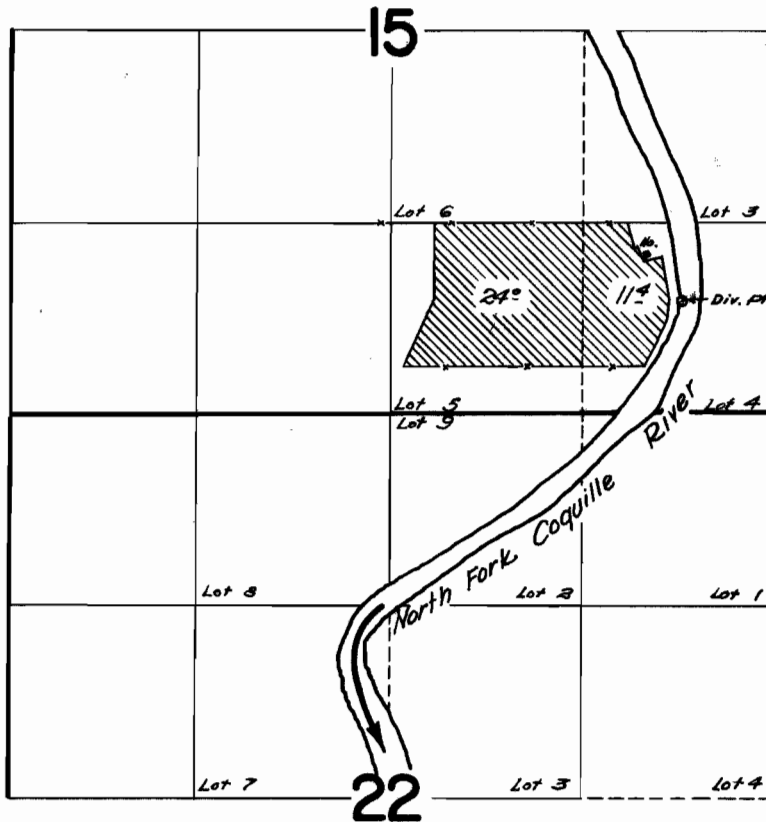

FINAL PROOF SURVEY
UNDER

Application No. 31740 Permit No. 25037
IN NAME OF

HOWARD HAGA

Surveyed August 7, 1961, by C. O. Bartels