


T.26S.R.12W.W.M.

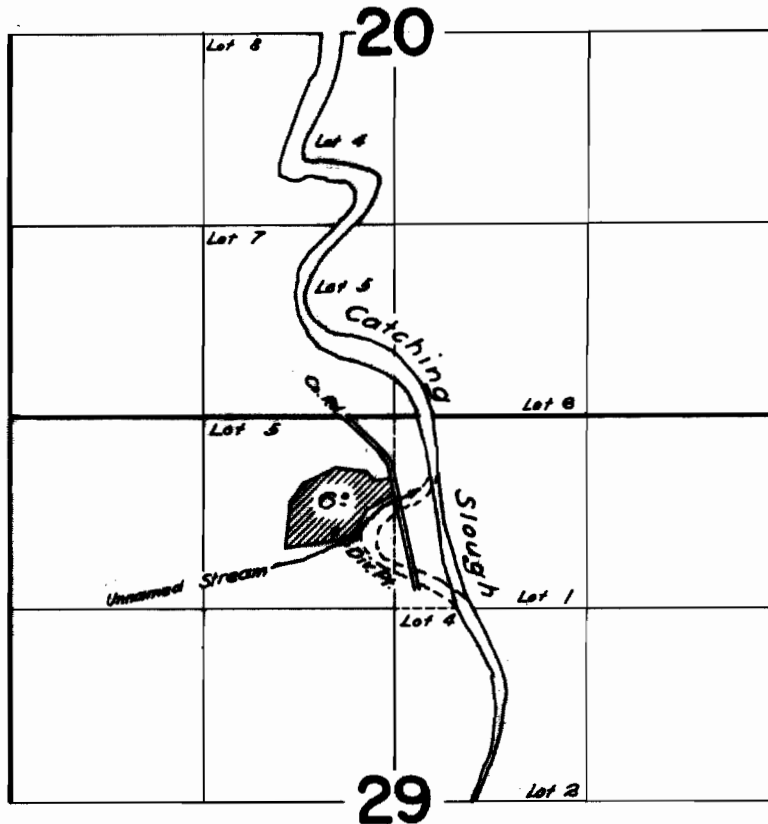

FINAL PROOF SURVEY
UNDER

Application No. ~~31003~~ Permit No. 25130.....
IN NAME OF

DINTY MOORE

Surveyed August 11, 1961., by C.O. Bartels.

8