


T.35S.R.11W.W.M.

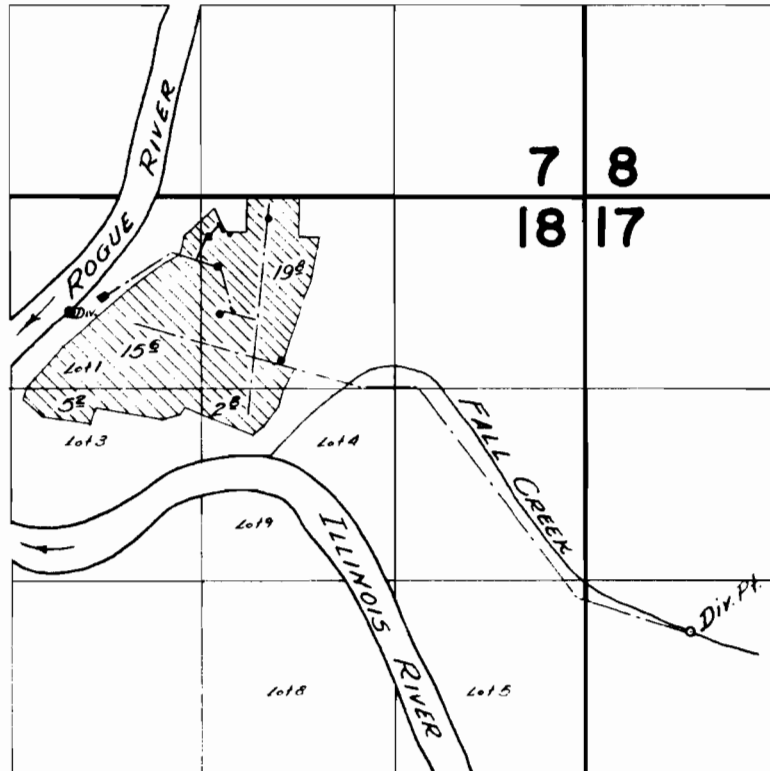

- Houses
- Cabins
- Stock Troughs
- Pipelines

32317
26720

25527
20911

D. D. LUCAS

Aug. 26th 1961

cc Bartels