


# T.35S.R.11W.W.M.

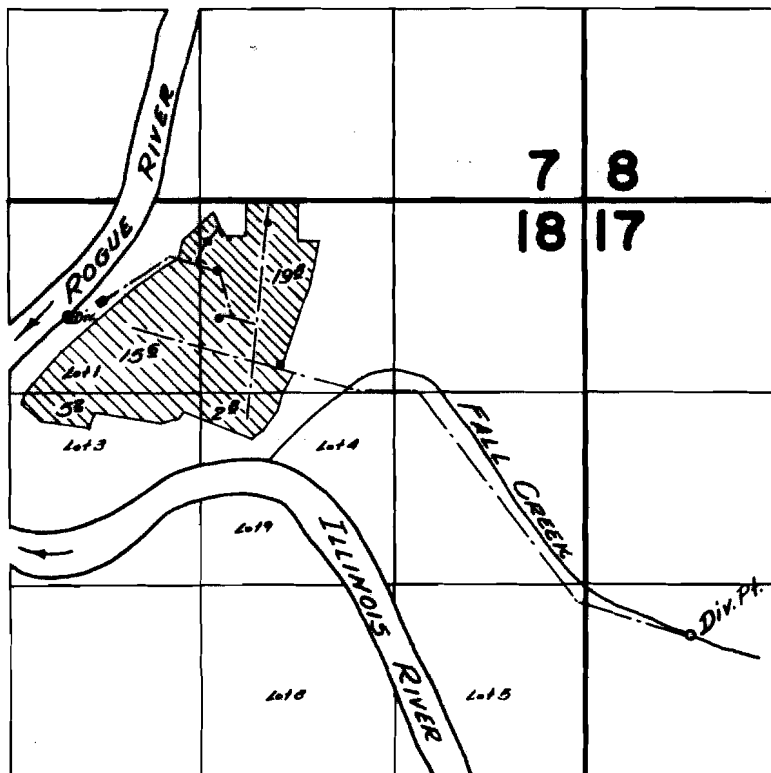

- ..... Houses
- ..... Cabins
- ..... Stock Troughs
- ..... Pipelines

## FINAL PROOF SURVEY

UNDER

Application No. 32317 25527  
~~26720~~ Permit No. 20911

IN NAME OF

D. D. LUGAR

Surveyed Aug. 26<sup>th</sup> 1961, by W. Bartels