


T.34S.R.II W.W.M.

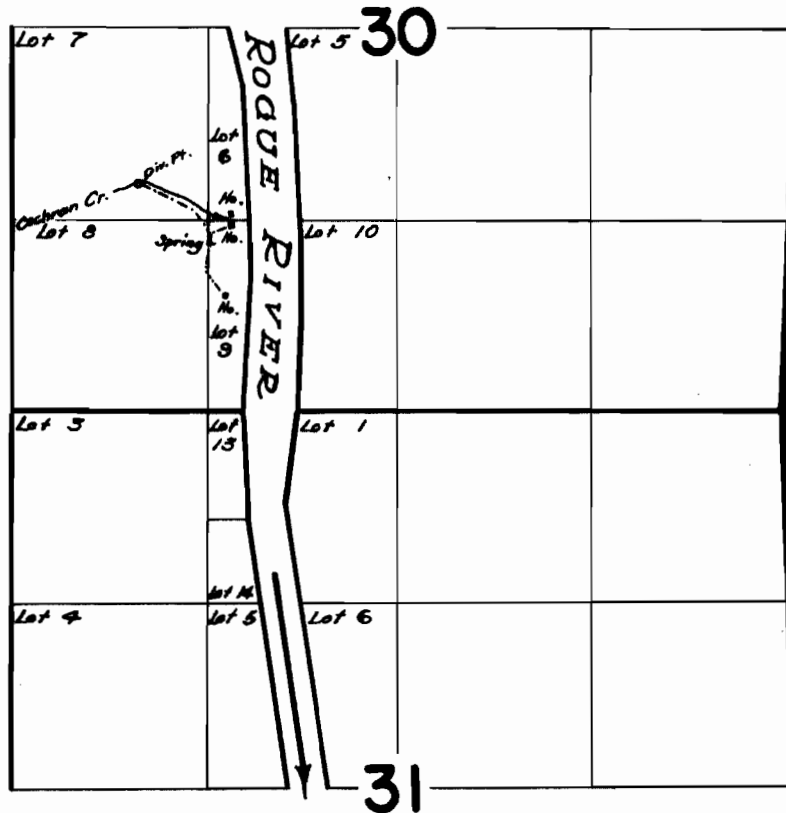

FINAL PROOF SURVEY
UNDER

Application No. **33244**... Permit No. **29337**...
IN NAME OF

KATE VAN DUYN COCHRAN

Surveyed *August 29 1961*, by *C. O. Bartels*.