


Map of NE. $\frac{1}{4}$ of Sec. 25, T.P. 1 So., R.21 E. W.M.

Spring as shown is located in S.E. $\frac{1}{4}$ of N.E. $\frac{1}{4}$ Sec.25, R, 21 E. W.M.

Scale 16" to mile.

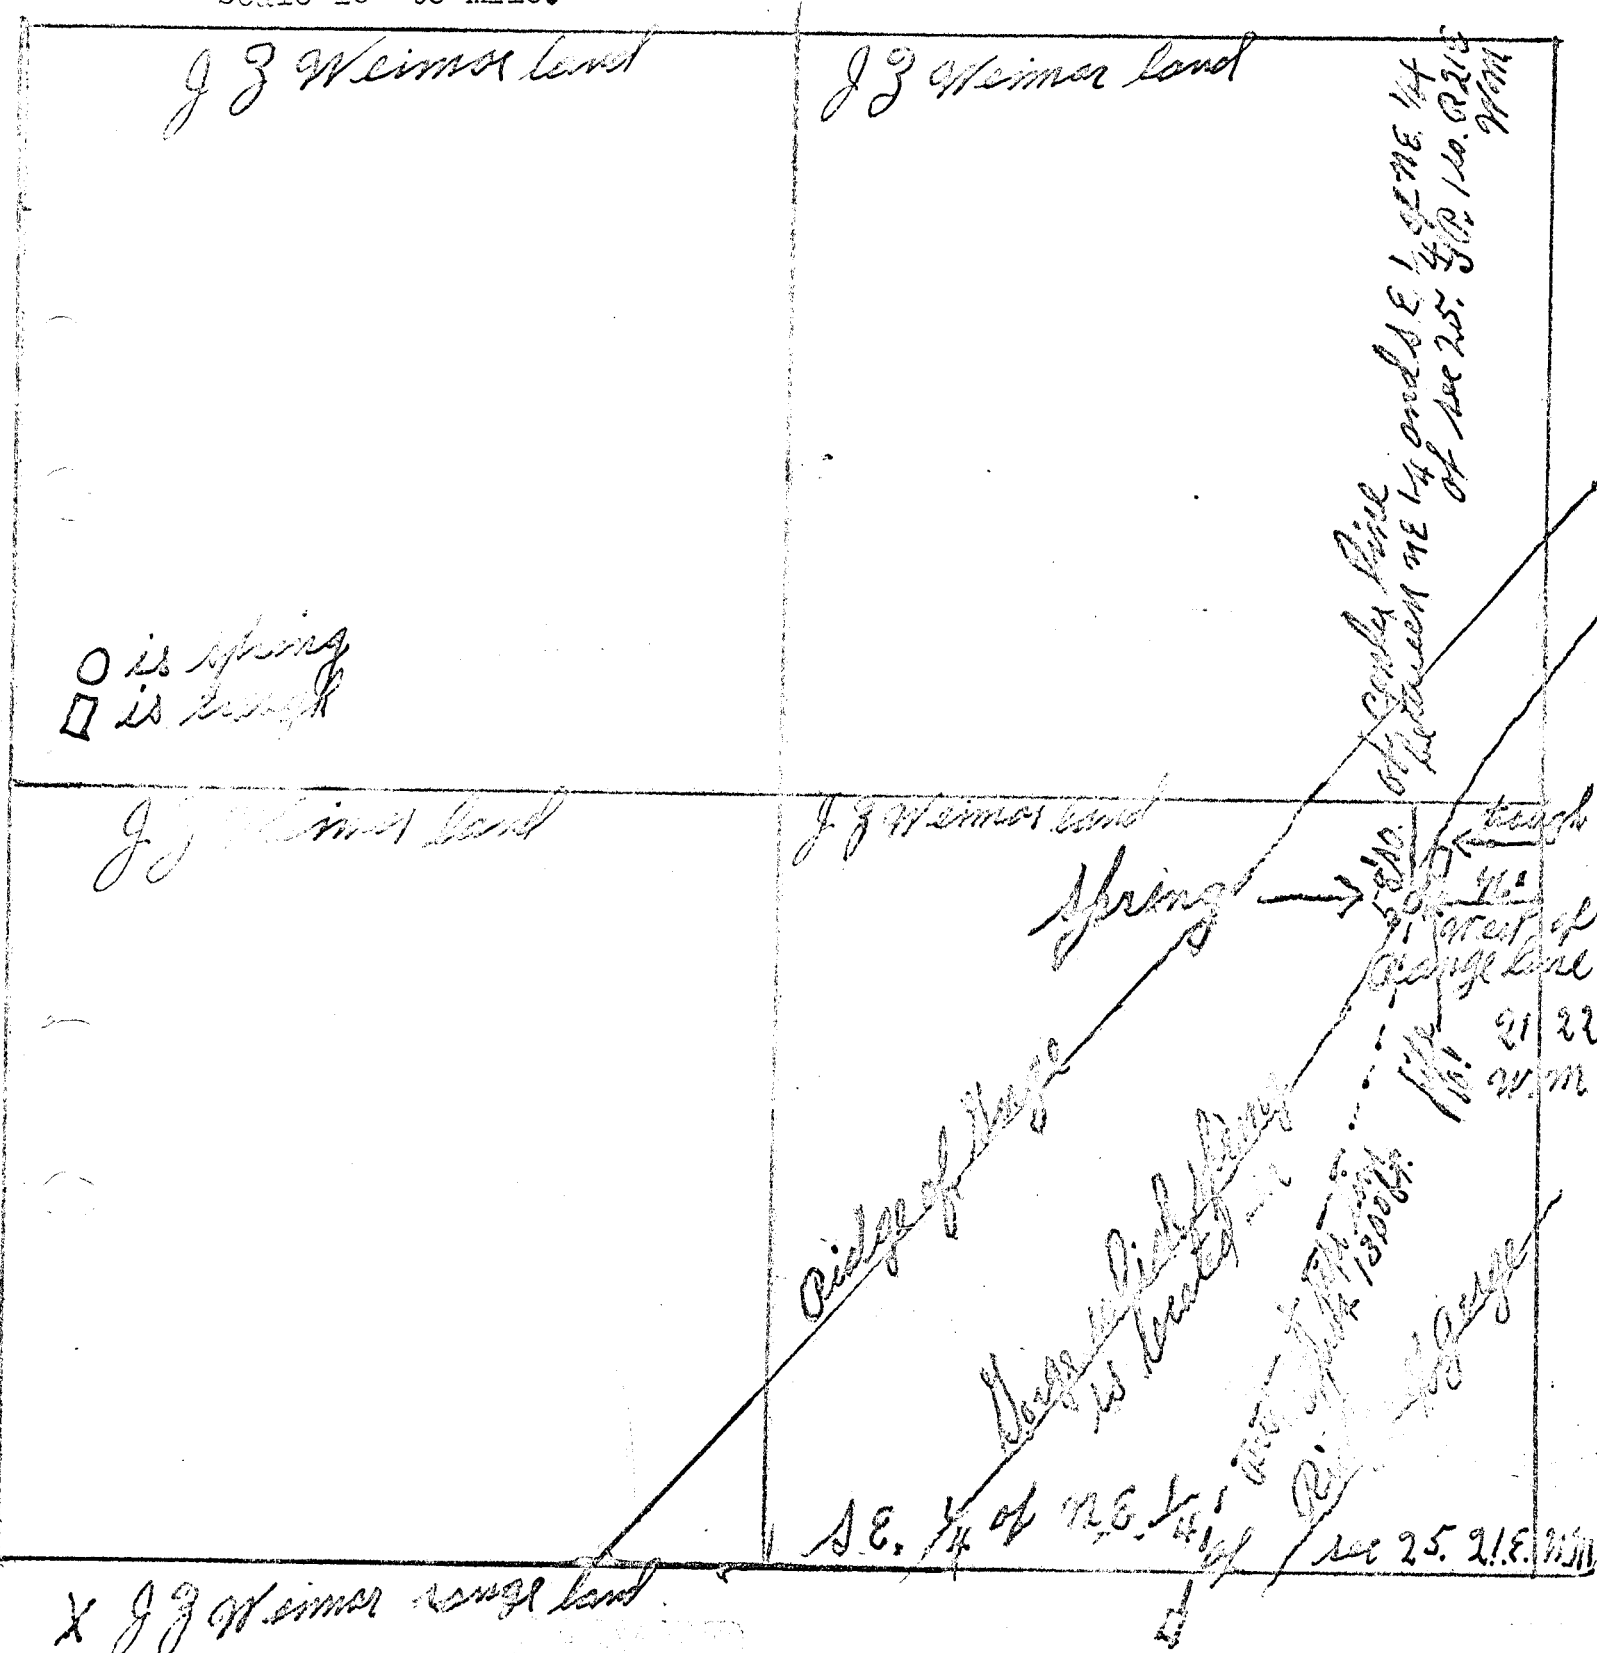

X J J Weimer land

Applicant No. 29782
Permit No. 23576