


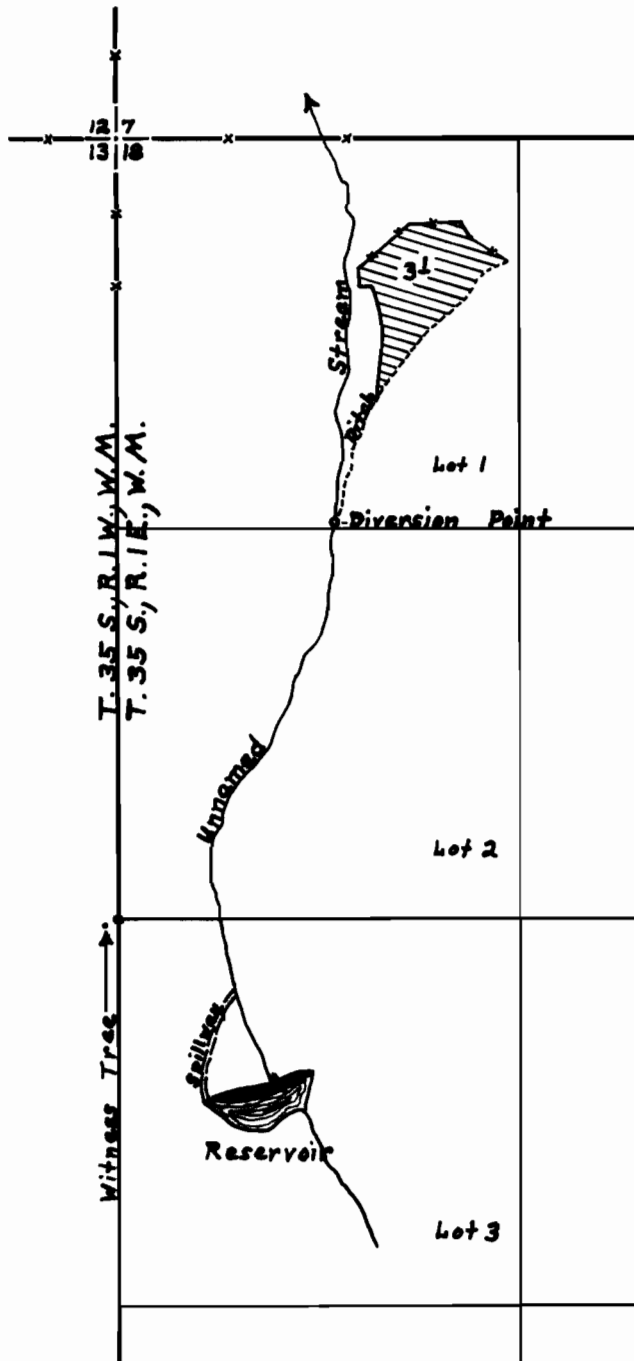

FINAL PROOF SURVEY UNDER

Application No. R-26347 Permit No. R-2046
26348 25016
IN NAME OF

Burton R. Sims

Surveyed May 31, 1962, by D. L. Hendrix

Scale: 8" = 1 mile