

T.41S., R.15E., W.M.

Rock Creek

Dam Monument

N.65°03'E.
N.65°18'E.

29631
29901

01

56

326

131

Ditch

238

Ditch

1

58


20

3

4

146

OREGON
CALIFORNIA

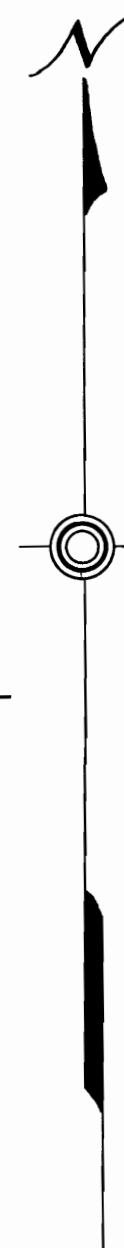

I, William L. Wales, of Klamath Falls, Oregon, do hereby certify that this map was made from notes taken during an actual survey made by me and completed on November 20, 1954, that the monument shown on this map, consisting of a 3/4" iron pipe 36" long, driven into the ground 24" is N.65°18'E. - 29901 feet from the Southwest corner of Section 17, T.41S., R.15E., W.M.

William L. Wales

Registered Professional Engineer
Date of Registration, Aug. 4, 1927.

Oregon No. 1347.

William L. Wales

MAP SHOWING
LANDS TO BE IRRIGATED
BY
NEVA L. GROHS
KLAMATH COUNTY, OREGON
Scale: 1" = 400'
Survey & Map By: William L. Wales
Civil & Hydraulic Eng'r.
Klamath Falls, Oregon.

R-30213
Application No. 29204
Permit No. R-1916
24406