

T.41S., R.15E., W.M.

Monument


N.65° 50 1/2' W.
2809'



Gwinn Spring

S.4° 59 1/2' W. - 97.6'

Diversion Dam

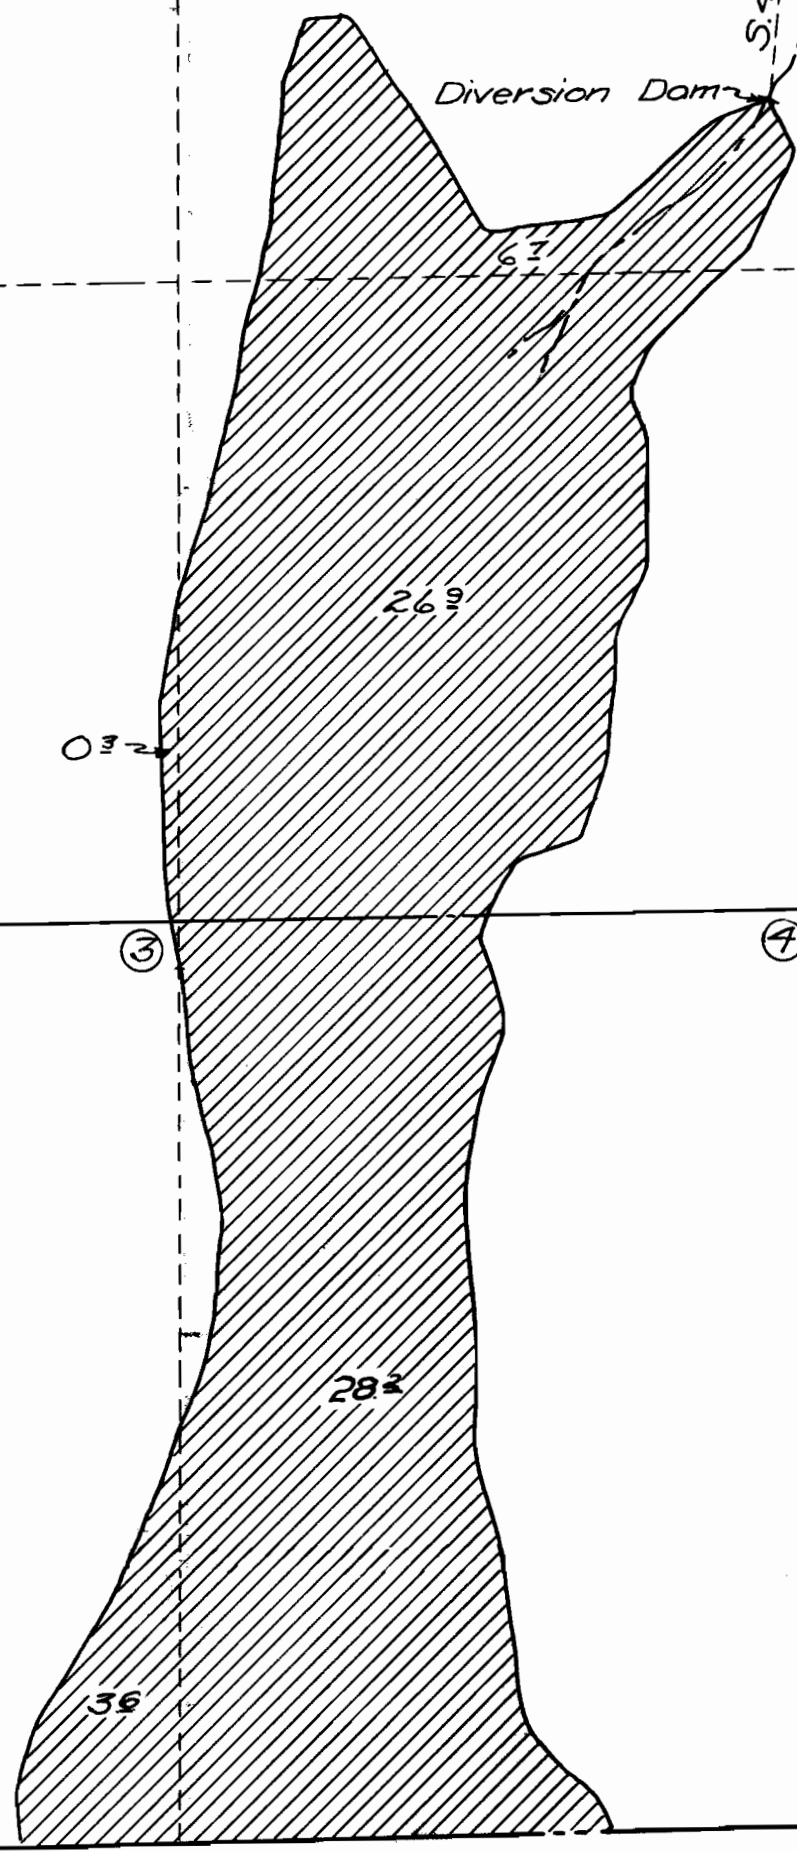

I, William L. Wales, of Klamath Falls, Oregon, do hereby certify that this map was made from notes taken during an actual survey made by me and completed on November 20, 1954, that the monument shown on this map, consisting of a 3/4" iron pipe 36" long, driven into the ground 24" is N.65° 50 1/2' W. 2809' feet from the Southeast corner of Section 17, T.41S., R.15E., W.M.

William L. Wales

Registered Professional Engineer
Date of Registration, Aug. 4, 1927.

Oregon No. 1347.

William L. Wales

①

② 20

③

④

OREGON
CALIFORNIA

Application No. R. 30213 & 30214
Permit No. R-1906 & 24408

MAP SHOWING
LANDS NOW IRRIGATED
BY
NEVA L. GROHS
KLAMATH COUNTY, OREGON
Scale: 1" = 400'
Survey & Map By: William L. Wales
Civil & Hydraulic Eng'r.
Klamath Falls, Oregon.