

T. 36 S. R. 14 & 15 E. W. M.


FINAL PROOF SURVEY  
UNDER


R-30717 R-1907  
Application No. 29551 Permit No. 24407

IN NAME OF

Henry C. & Mariam Gerber  
Dave J. & Elizabeth Campbell

Surveyed July 19, 1961 by *M. Bish*

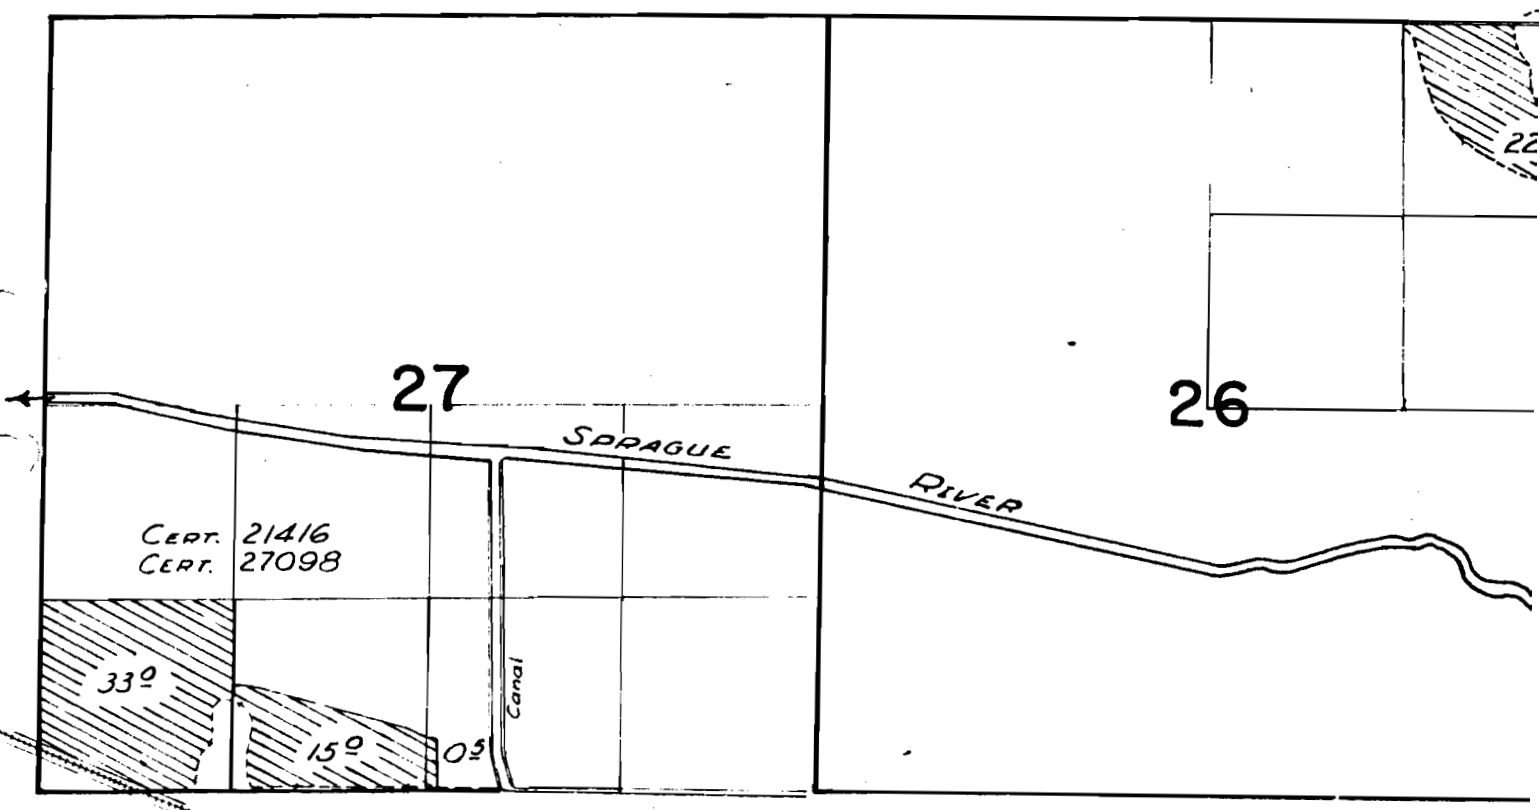

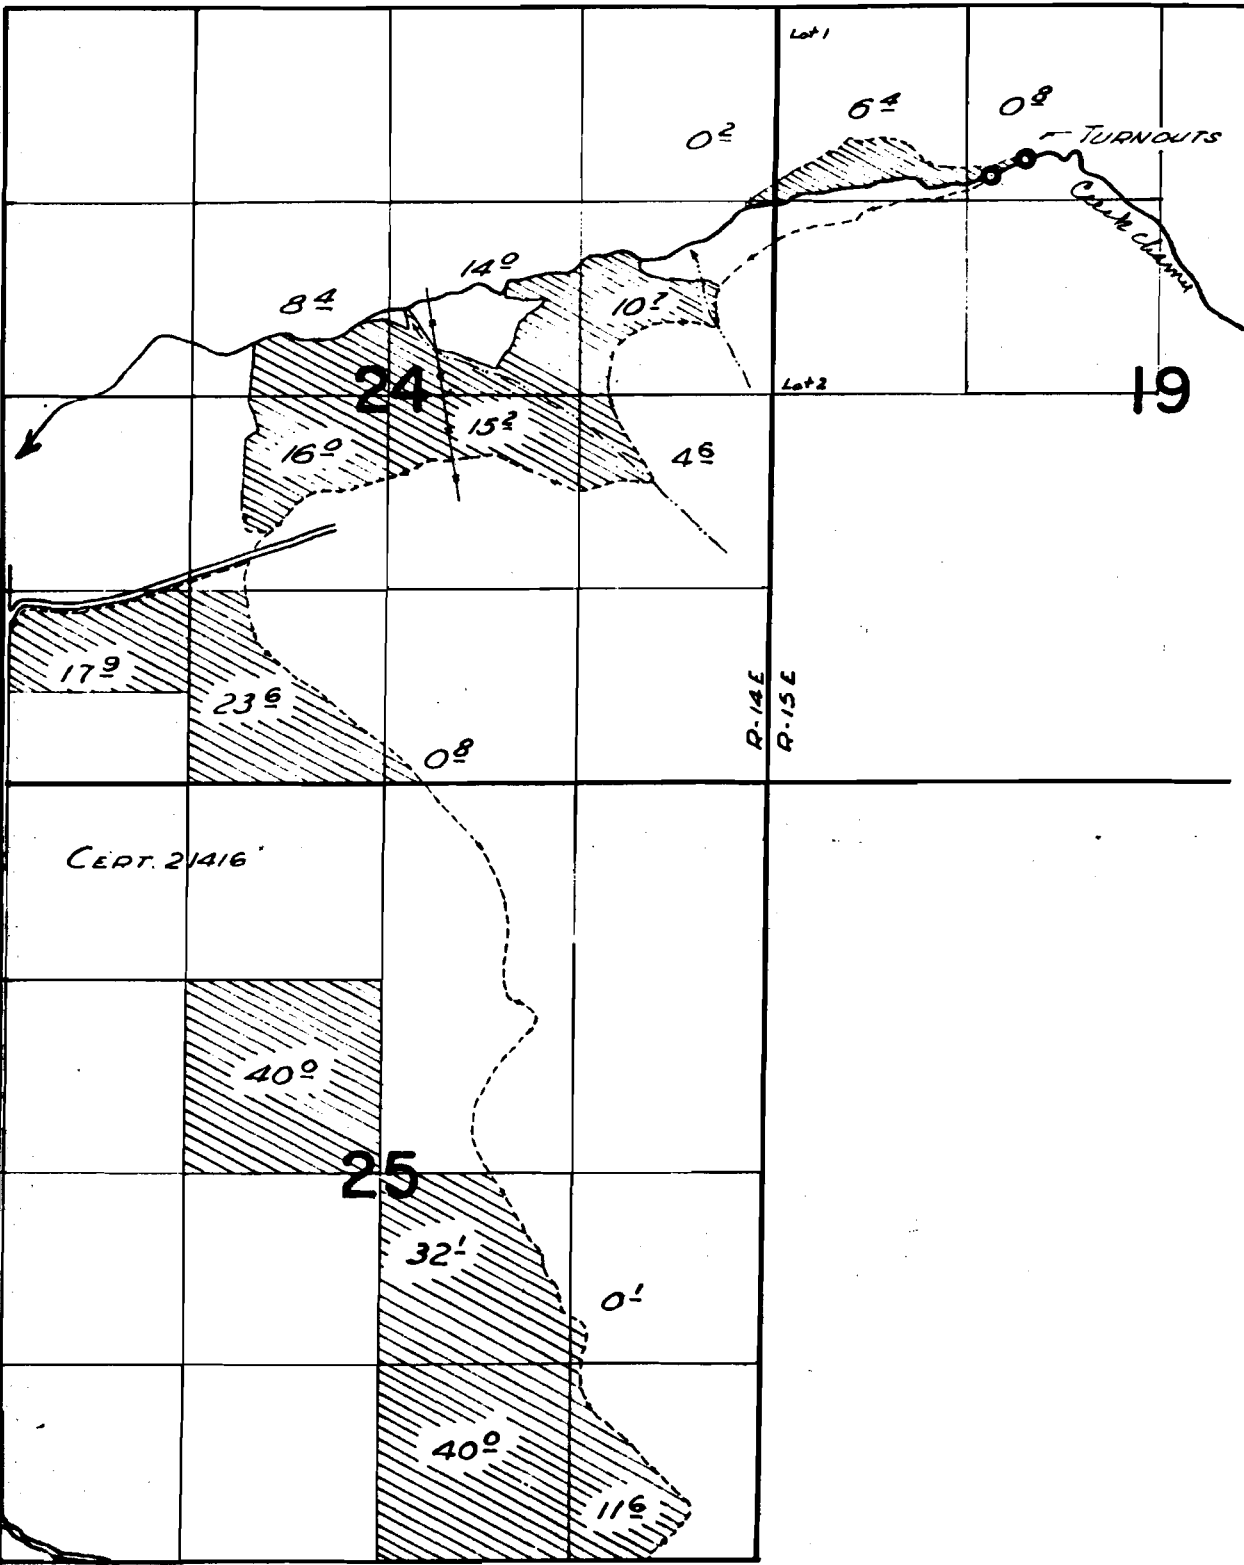

R-1907, 24407