


T.12S. R.88&9W.W.M.

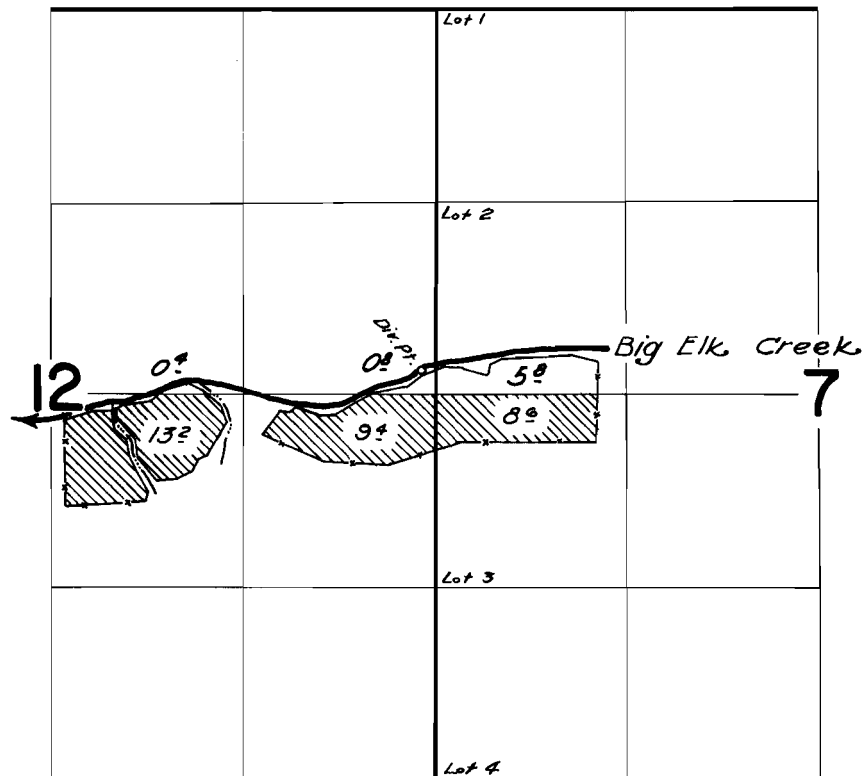

FINAL PROOF SURVEY
UNDER

Application No. 29841 Permit No. 23467
IN NAME OF

DELBERT A. KESSI

Surveyed Sept. 28. 1961. by Ch. Jackson