


T. 10S. R. 2W. W.M.

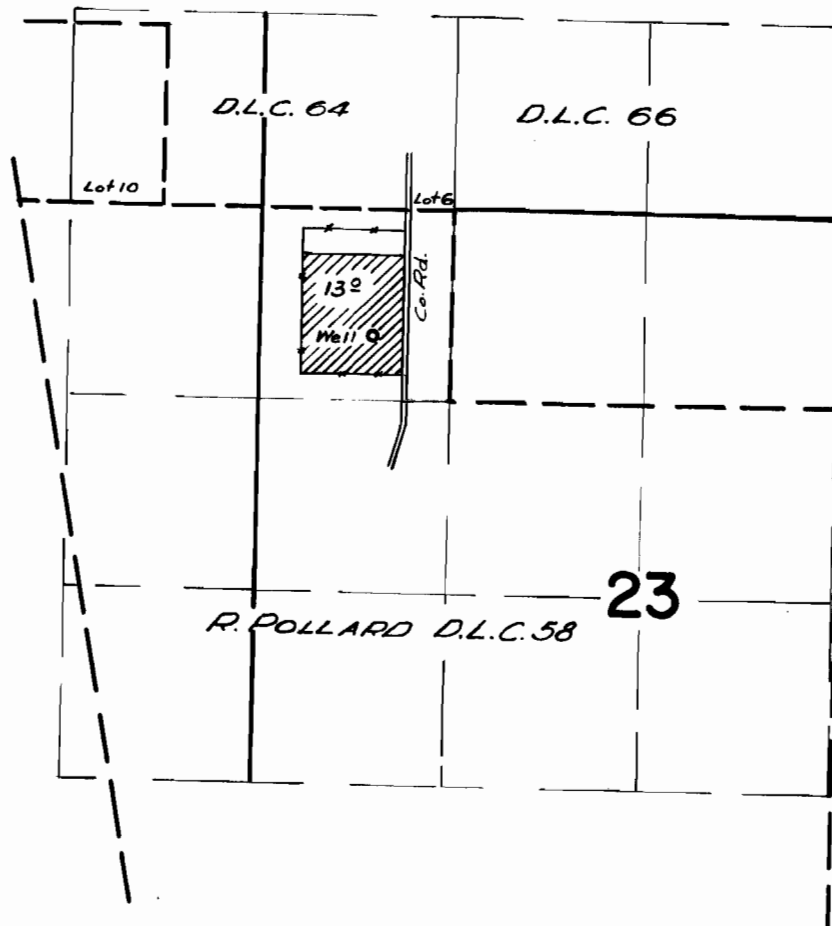

FINAL PROOF SURVEY

UNDER

Application No. G-613 Permit No. G-534

IN NAME OF

R. N. & MARIAN GOAR

Surveyed 15 MAY 1961, by M. B. Bish