


T.10S.R.3W.W.M.

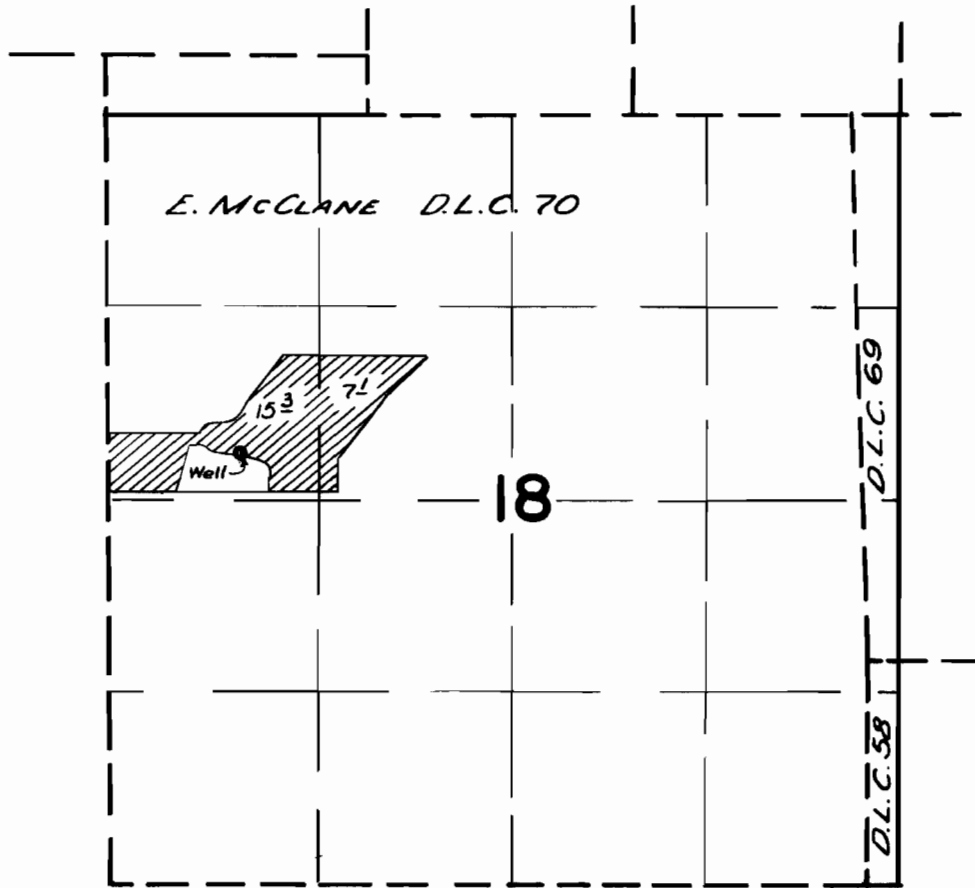

FINAL PROOF SURVEY UNDER

Application No. G-969 Permit No. G-818
IN NAME OF

O. J. ROHNER

Surveyed 31 MAY 1961, by M. B. B.