


T.14S.R. 4W.W.M.

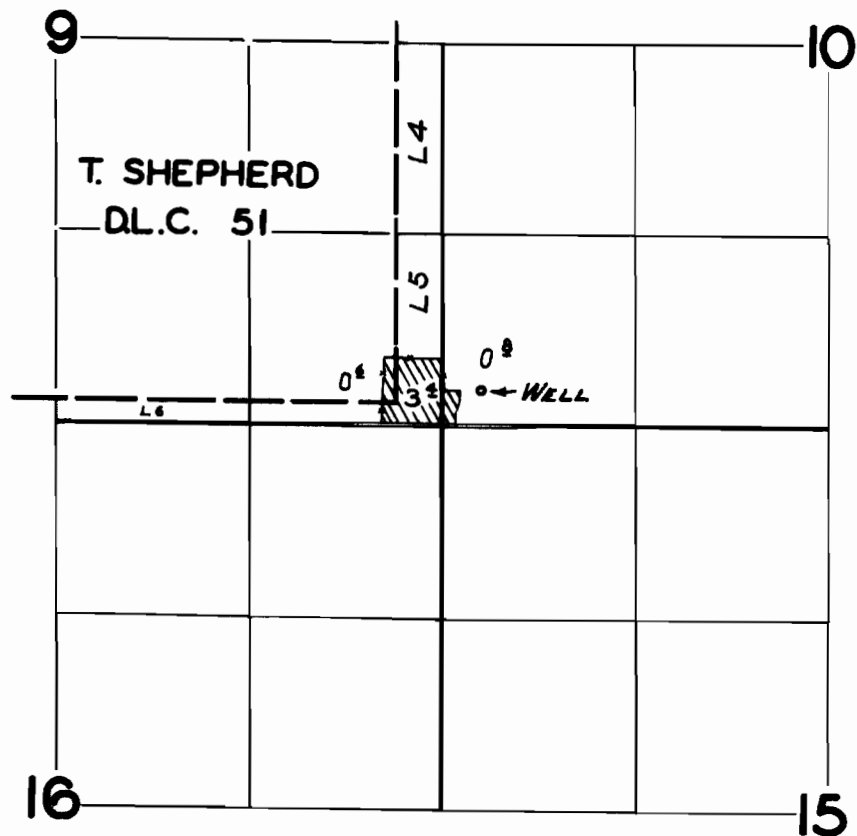

FINAL PROOF SURVEY
UNDER

Application No. G-1129 Permit No. G-987
IN NAME OF

OTTO A. WETGEN

Surveyed JUNE 19 1961, by M. BISH