


T.12S.R. 1W.W.M.

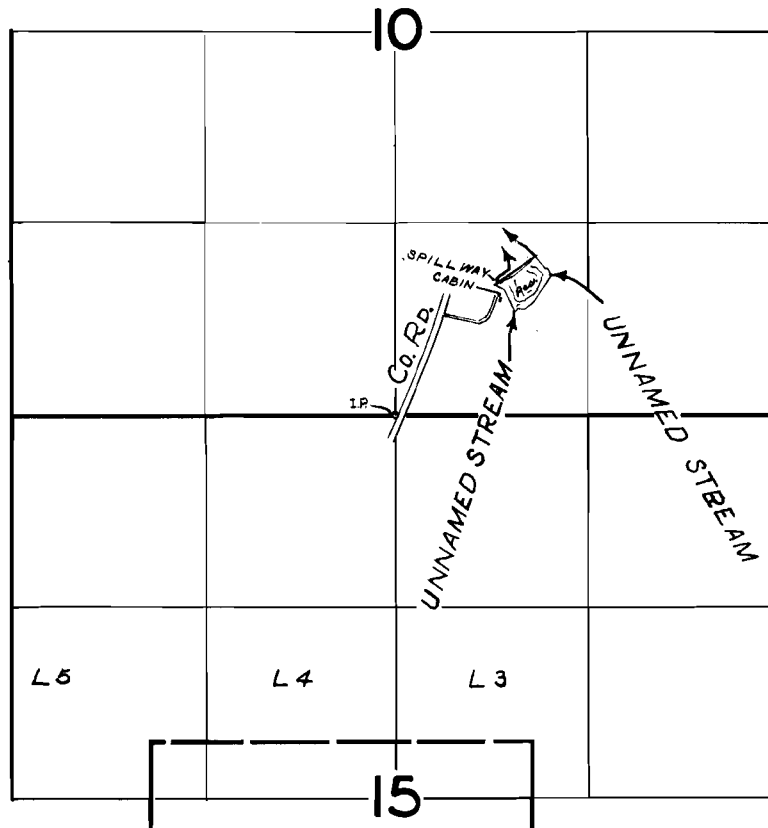

FINAL PROOF SURVEY
UNDER

Application No. *R-31154* *R-1952*
31155 Permit No. *24552*
IN NAME OF

ELWIN S. & OLIVE C. TAYLOR

Surveyed *JUNE 5* 1961 by *M. BISH*