


T.9 S.R.1 W.W.M.

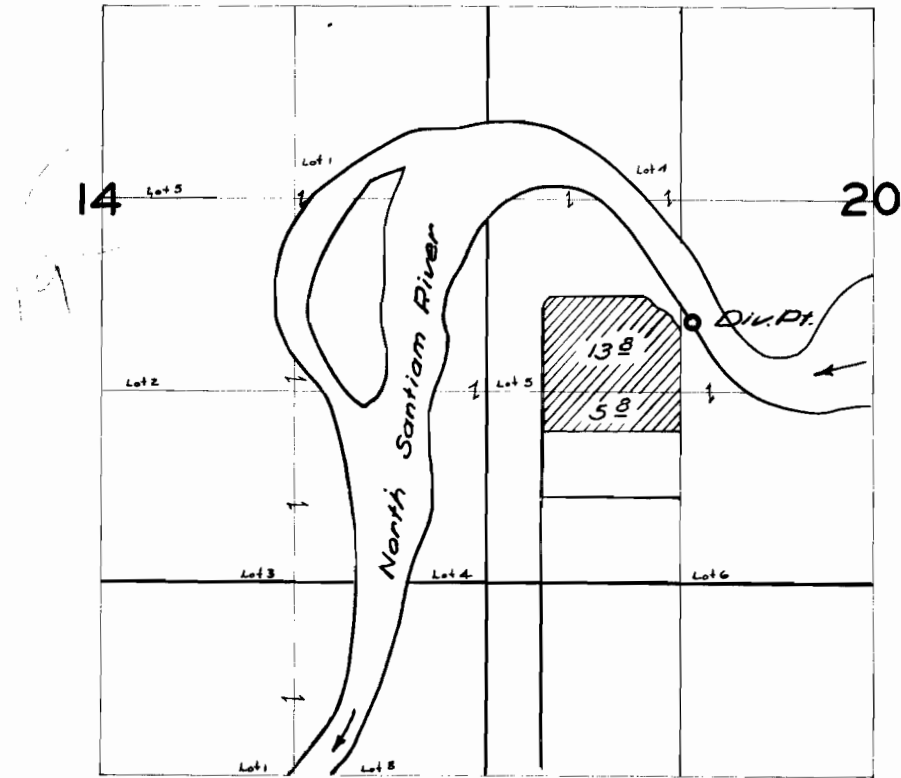

FINAL PROOF SURVEY UNDER

Application No. 31739 Permit No. 25036
IN NAME OF

HOWARD CAREY

Surveyed 8 JULY 1960 by Mc. B. B.