


T.27S. R.38E. W.M.

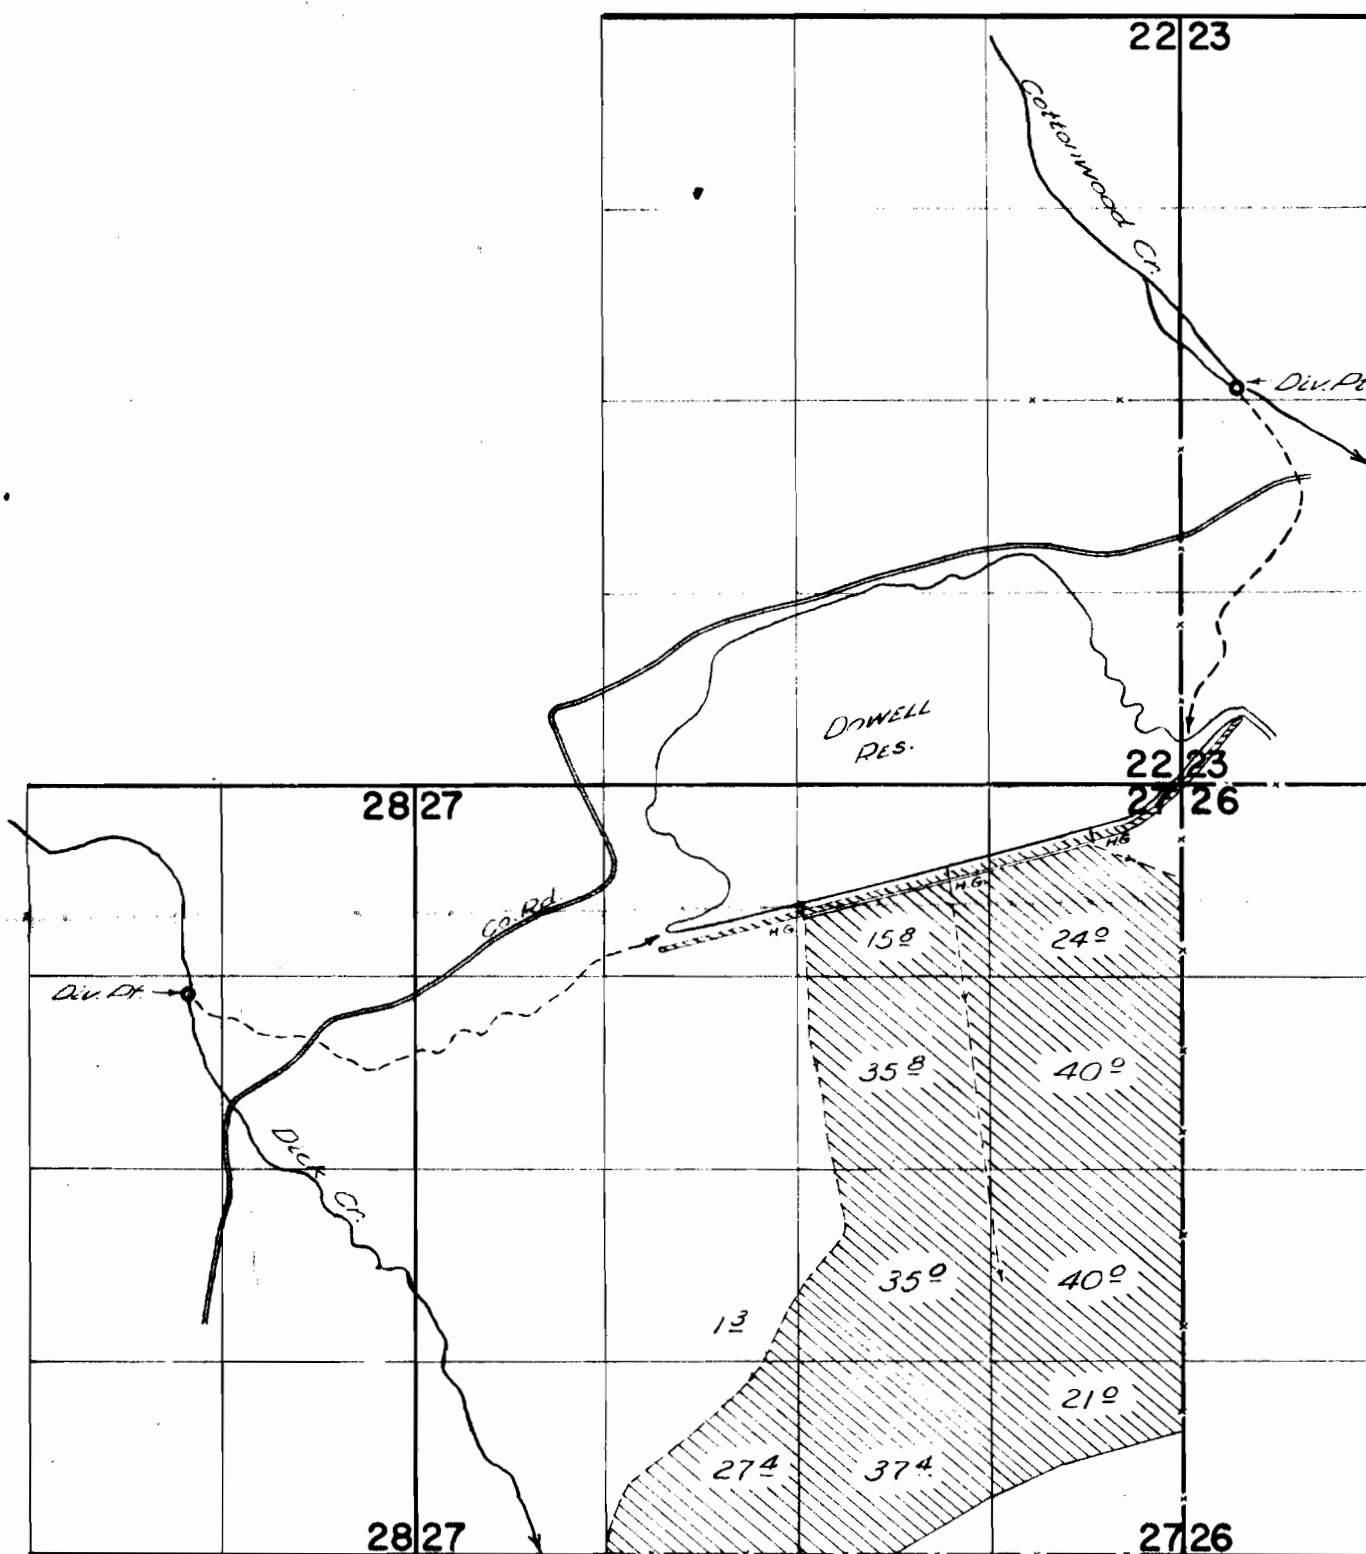

FINAL PROOF SURVEY

UNDER

Application No. 25499 Permit No. 20036
P-25498 R1109

IN NAME OF

THOS. DOWELL

Surveyed 20 Oct 1961, by M. Bish