


T. 5 S. R. 2 W. W. M.

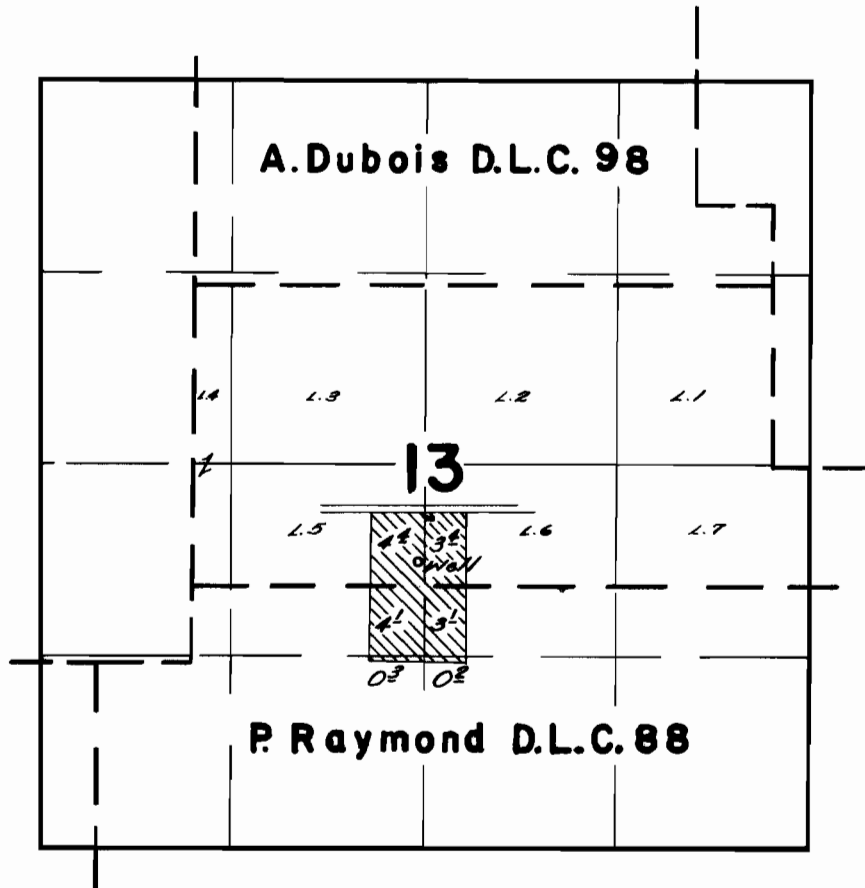

FINAL PROOF SURVEY UNDER

Application No. **G-686** Permit No. **G-594**
IN NAME OF

Lee A. & Mottie Terry

Surveyed Sept. 29 1961, by *[Signature]*