


T. 5S. R. 1W. W.M.

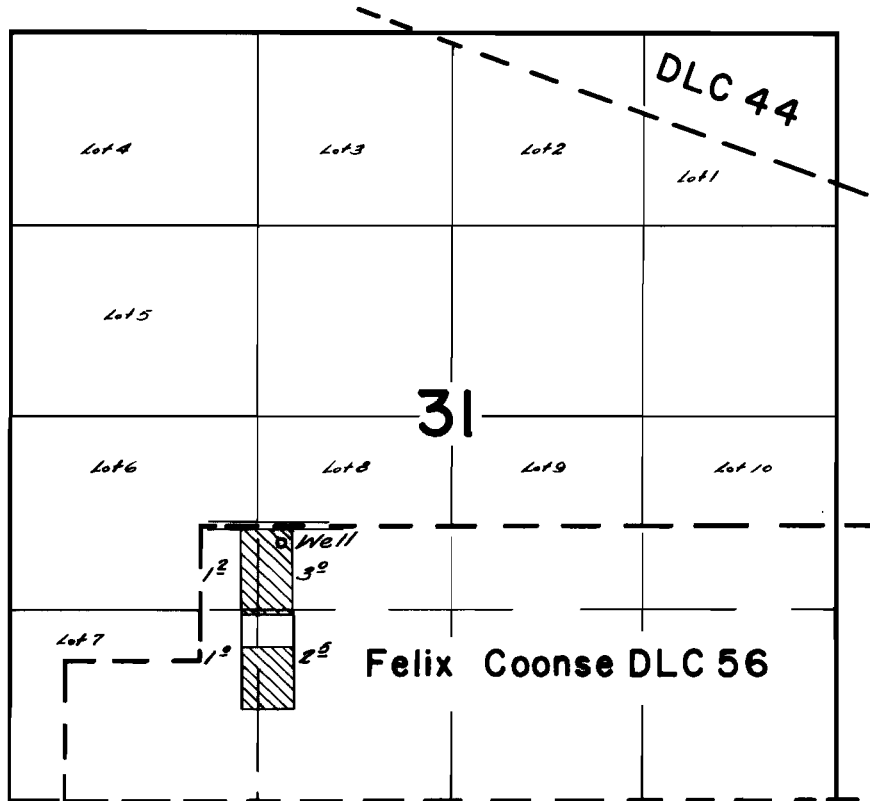

FINAL PROOF SURVEY UNDER

Application No. G-899 Permit No. G-797
IN NAME OF

Clair Smith Harvey

Surveyed Sept. 26 1961, by C.O. Bartels