


T.5S.R.1W.W.M.

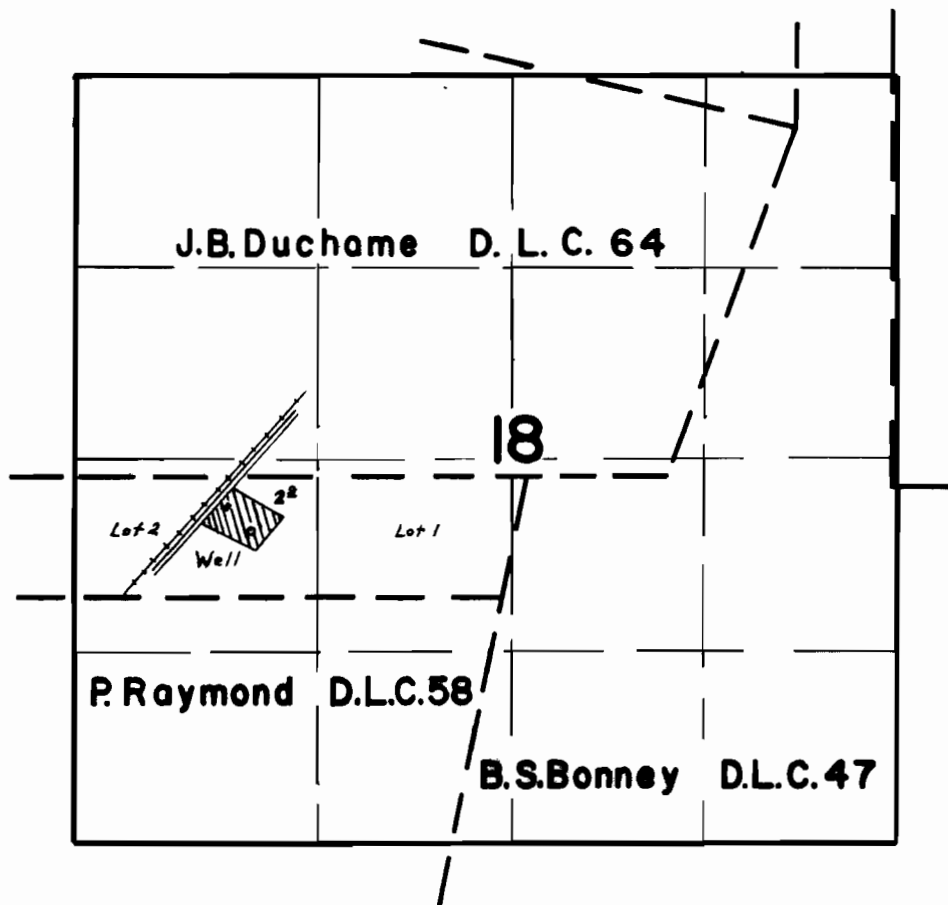

FINAL PROOF SURVEY UNDER

Application No. G-1187... Permit No. G-997...
IN NAME OF

Ramona Gift

Surveyed Sept. 29 1961, by G. O. Bartels