T. 7 S. R. 2 W. W.M.

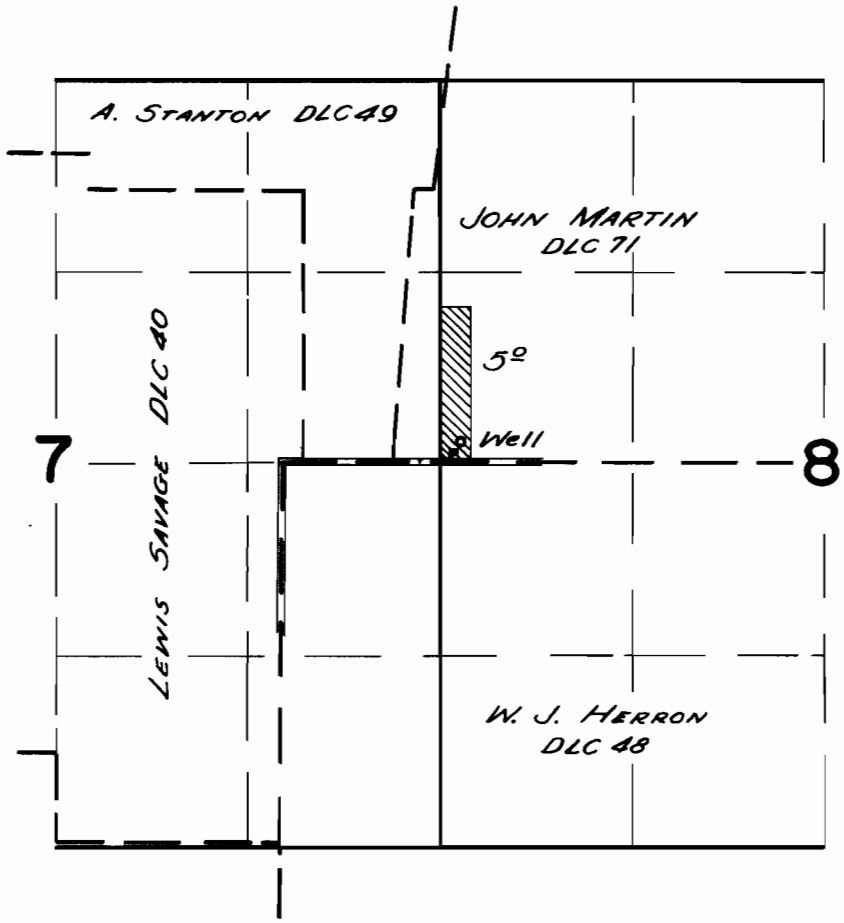

FINAL PROOF SURVEY
UNDER

Application No. G-1347 Permit No. G-1214
IN NAME OF

ALFRED G. GREGORY

Surveyed Sept. 26 1961, by C.A. Bartels

1961-T