


T.9 S.R. 2 W. W.M.

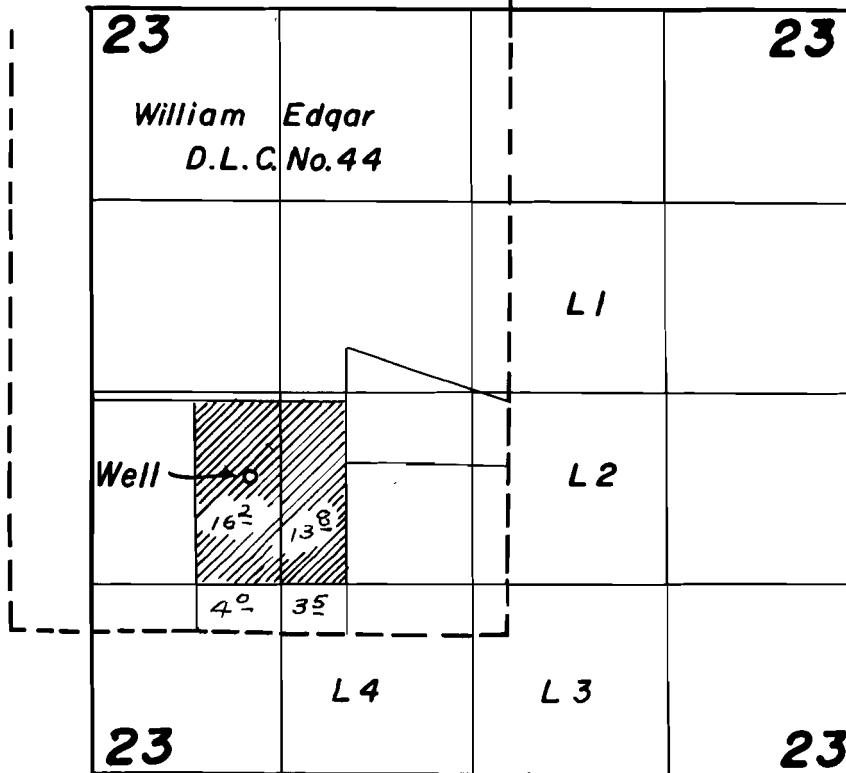

FINAL PROOF SURVEY
UNDER

Application No. G-1980 Permit No. G 1822
IN NAME OF

Honoras H. Ralphs

Surveyed June 26 1962, by Floyd L. Siegmund