


# T.4N.R.27E.W.M.

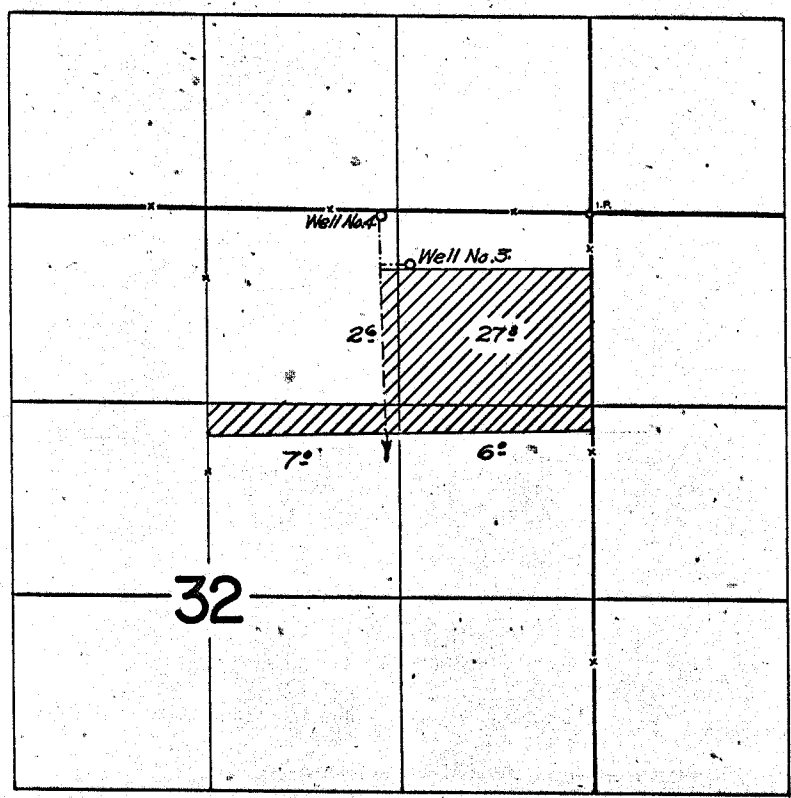

## FINAL PROOF SURVEY UNDER

Application No. G-534... Permit No. G-466...  
IN NAME OF

GEORGIA BELLE HOLZAPFEL

Surveyed October 3, 1961, by [Signature]