


6-1044

30121

T.2N.R.23E.W.M.

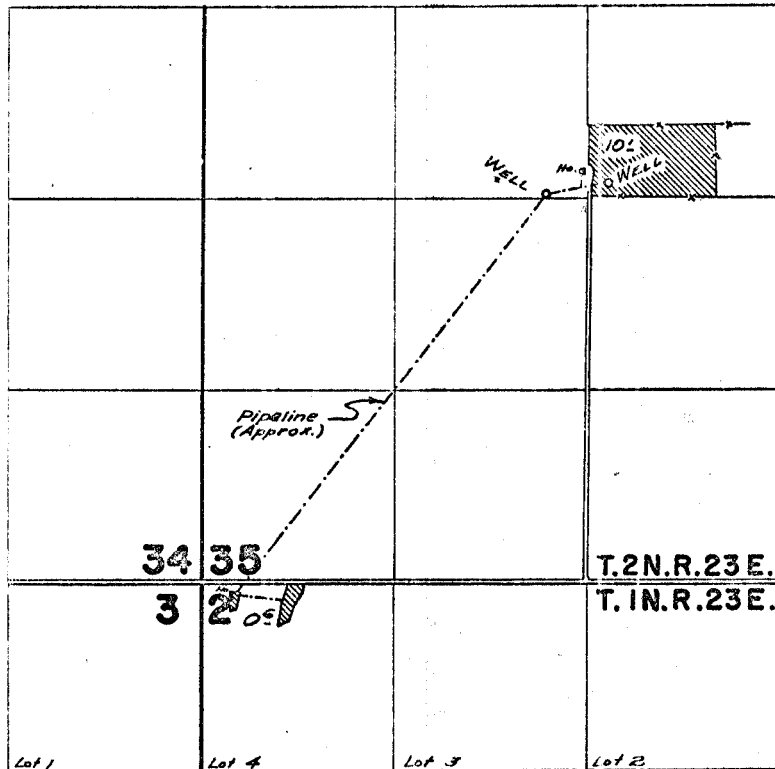

FINAL PROOF SURVEY
UNDER

Application No. G-1121.... Permit No. G-1044..
IN NAME OF

ESTATE OF SENA MILLER

Surveyed *October 10, 1961*., by

L. J. Jackson

1961-K