


T.1N.R.3E.W.M.

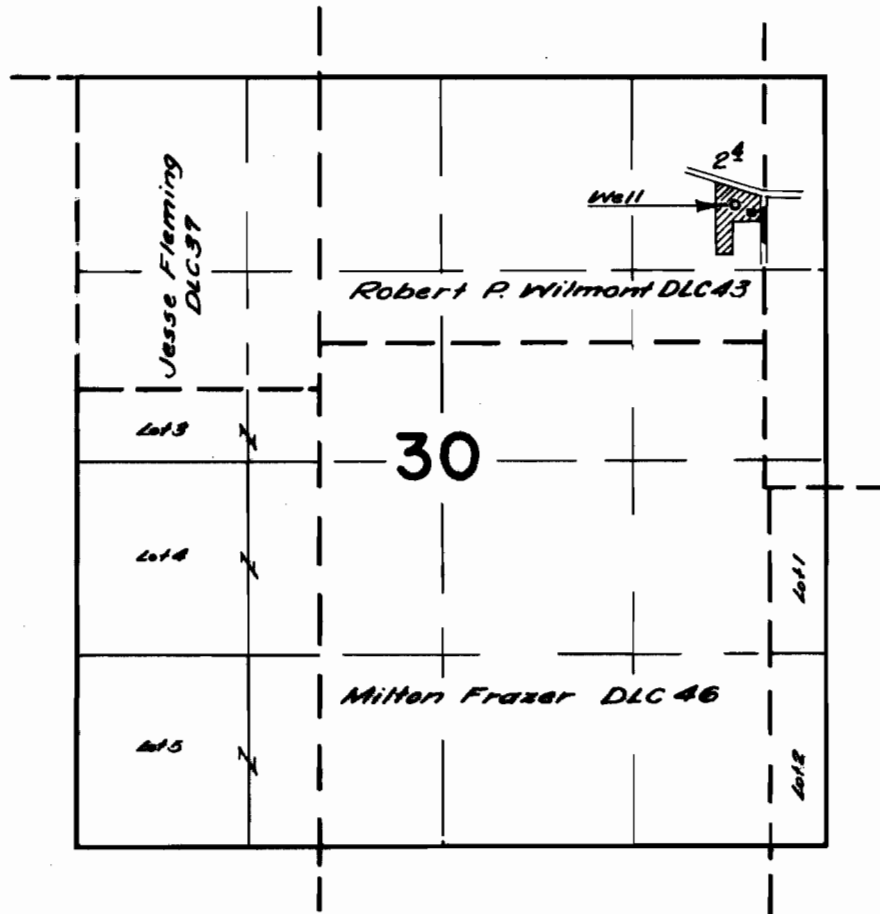

FINAL PROOF SURVEY

UNDER

Application No. G-1013 Permit No. G-884

IN NAME OF

LESLIE R. HARTLEY

Surveyed Aug. 15, 1961, by CRB Hartley