


T.7S.R.5W.W.M.

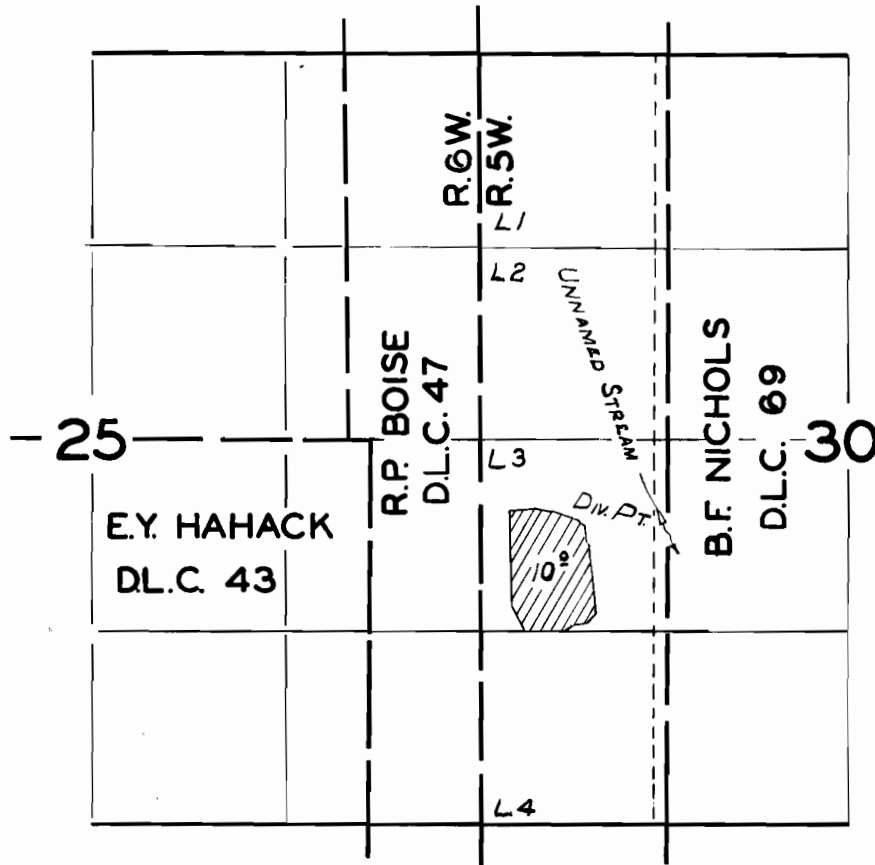

FINAL PROOF SURVEY
UNDER

Application No. 31542 Permit No. 24895
IN NAME OF

DON F. THORNTON

Surveyed July 8 1960 by C.O. BARTELS