


T. 1 S.R. 9 & 10 W.W.M.

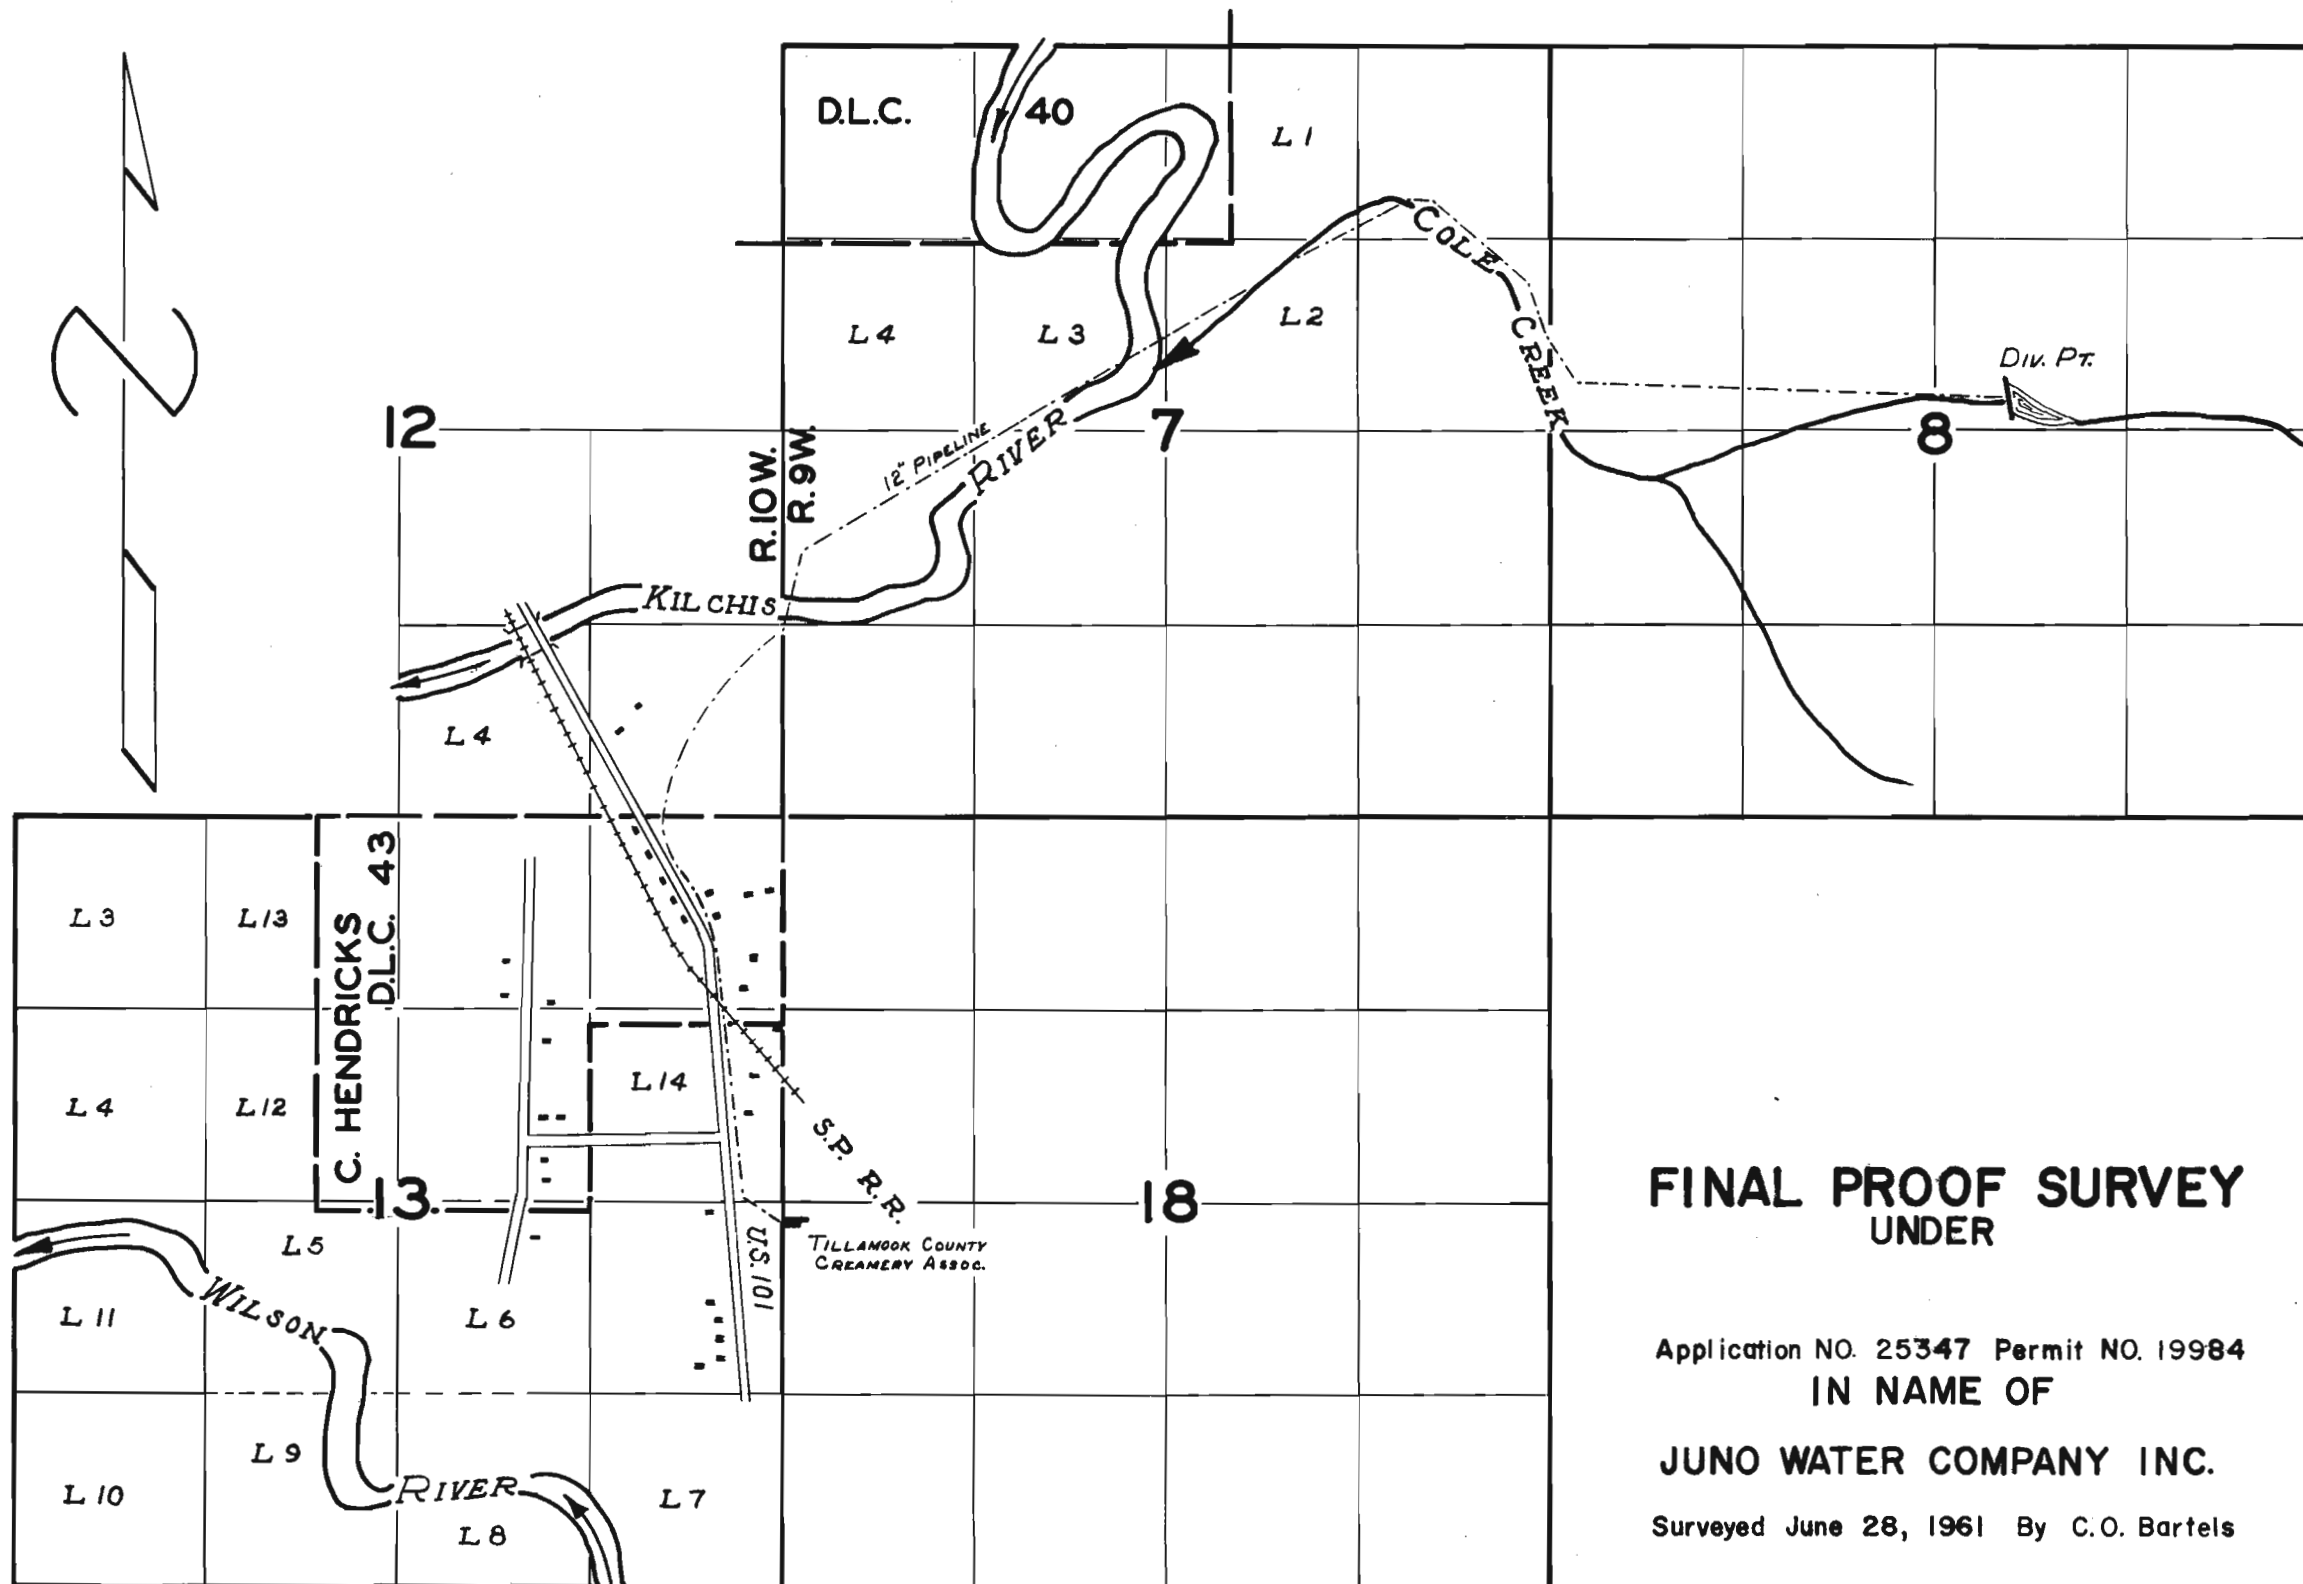

**FINAL PROOF SURVEY
UNDER**

Application NO. 25347 Permit NO. 19984
IN NAME OF

JUNO WATER COMPANY INC.

Surveyed June 28, 1961 By C.O. Bartels