


T. 4N.R.29E.W.M.

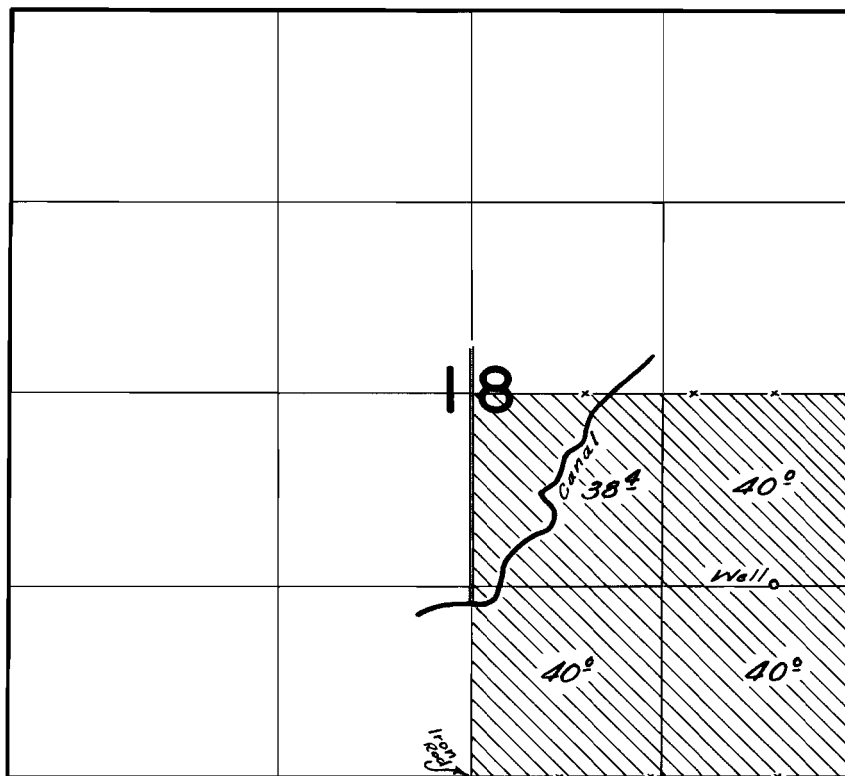

FINAL PROOF SURVEY UNDER

Application No. 44-564 Permit No. 44-517
IN NAME OF

MILTON & GLADYS GULP

Surveyed Sept. 21, 1961, by C. Bartlett