


T.6N.R.35E.W.M.

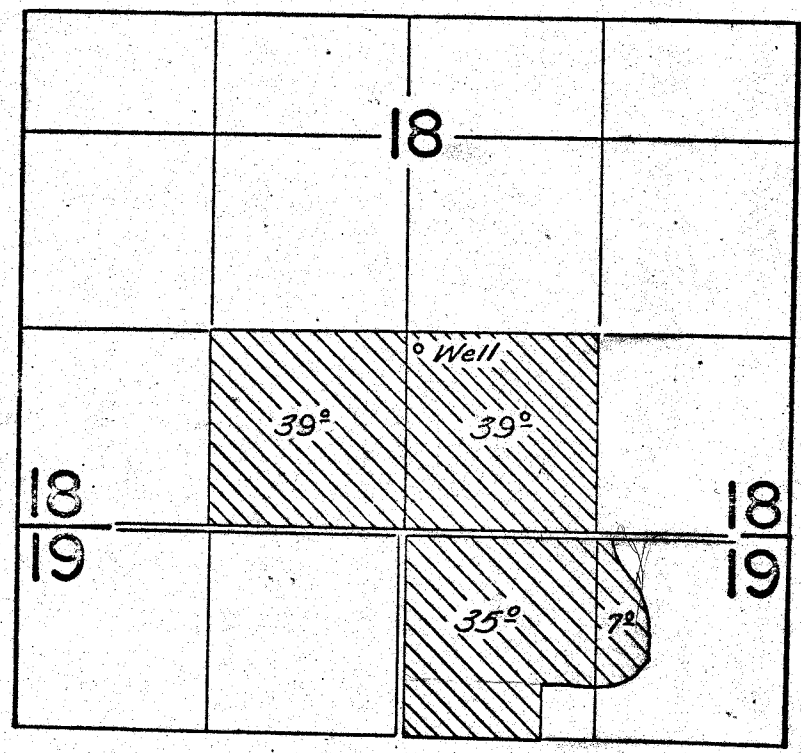

FINAL PROOF SURVEY

UNDER

Application No. G-603 Permit No. G-531

IN NAME OF

Dottie Christenson

Surveyed July 15, 1960, by M. Bish
Sept. 16, 1961 by C. B. White