


T.4N.R.35E.W.M.

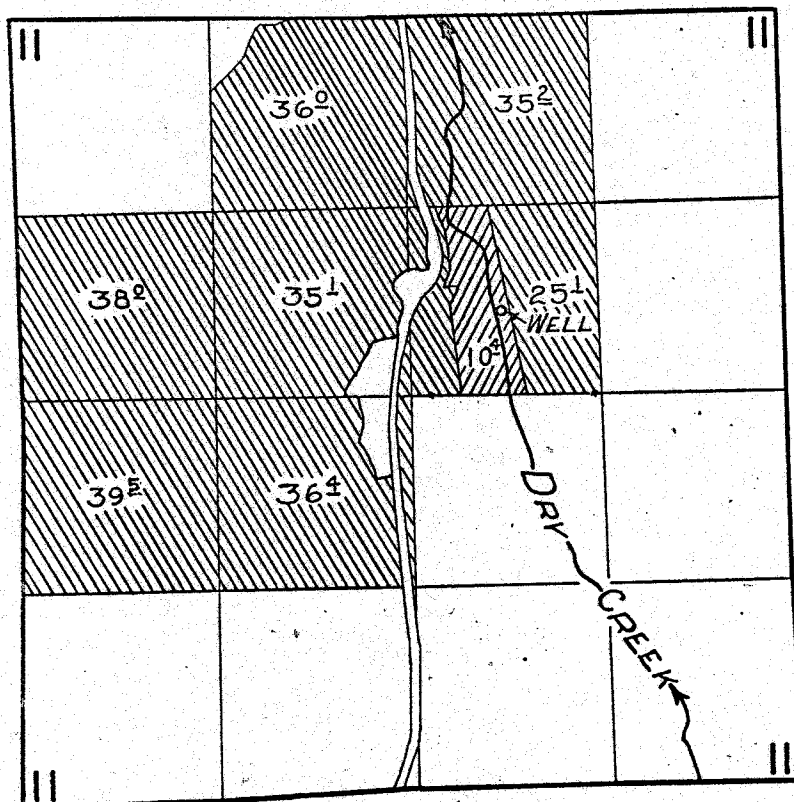

FINAL PROOF SURVEY

UNDER



PRIMARY

SUPPLEMENTAL



Application No. U-668..... Permit No. U-625.....
IN NAME OF

.....GEO. W. WINN.....

Surveyed JULY 21, 1960, by M. BISH.....