


6-910  
30132

# T.2N. R. 30E. W.M.

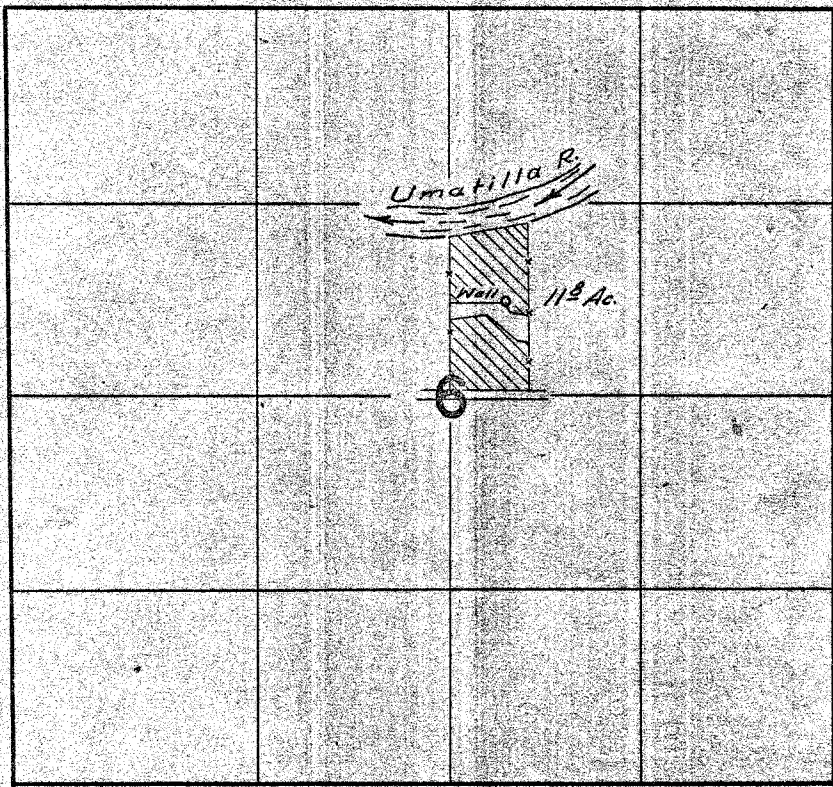

## FINAL PROOF SURVEY UNDER

Application No. *G-1047* Permit No. *G-910*.....  
IN NAME OF

.....*Melvin A. Dick*.....

Surveyed *Sept. 20, 1961*, by *O. B. Bartlett*.....