


T.5N.R.35&36E.W.M.

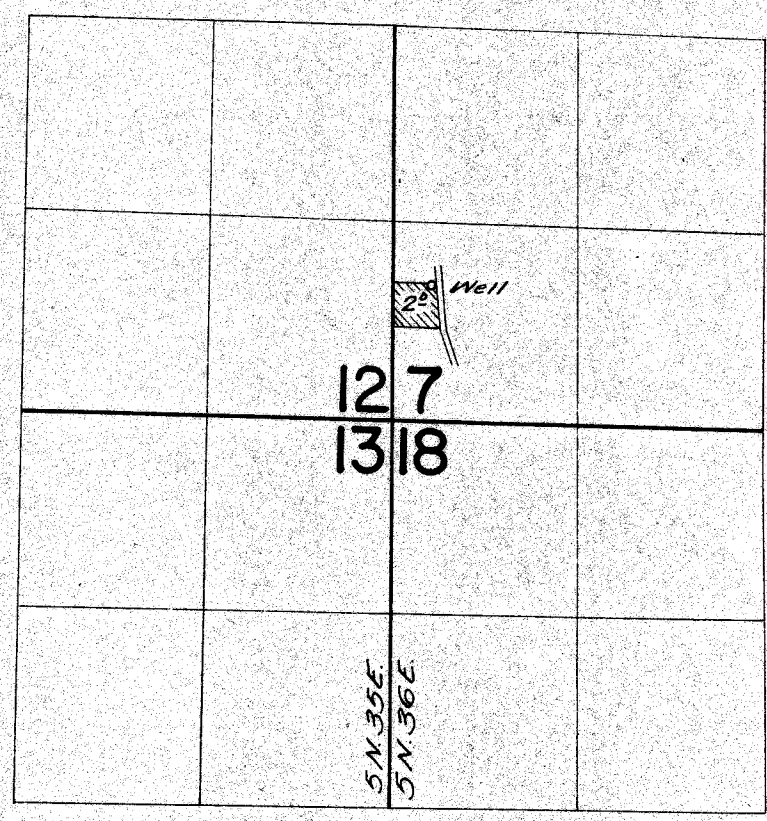

FINAL PROOF SURVEY UNDER

Application No. *G-1080* Permit No. *G-1150*
IN NAME OF

RAYMOND C. COX

Surveyed *Sept 16 1961*, by *CO Bartels*