


# T. 2 N. R. 30 E. W.M.

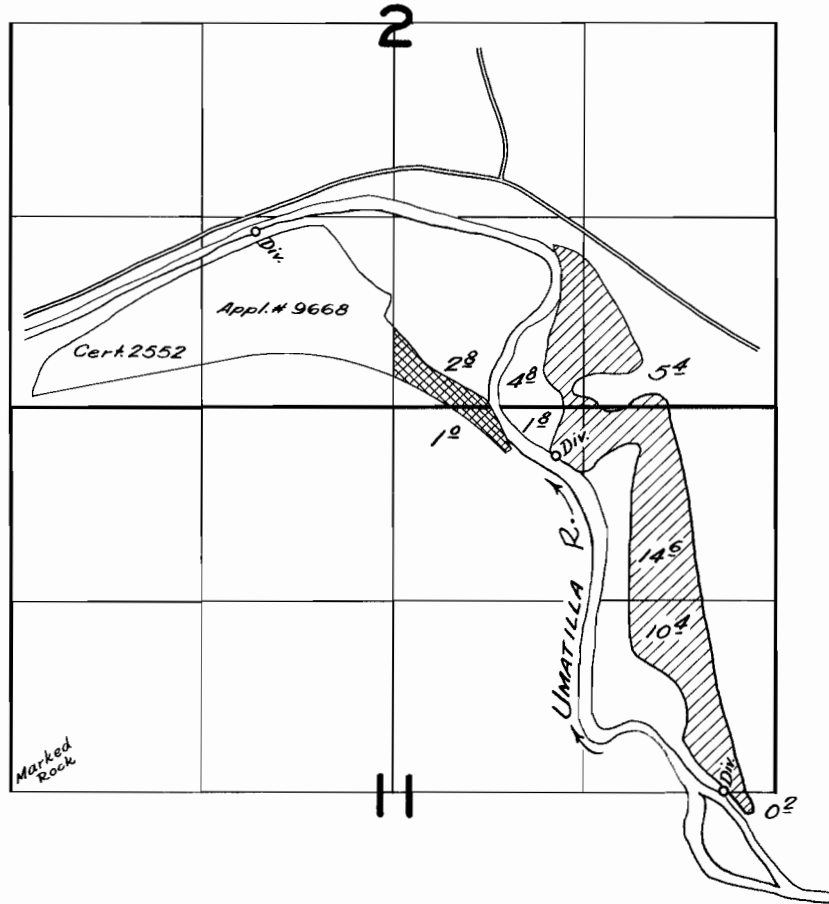

## FINAL PROOF SURVEY UNDER

Application No. 28455 Permit No. 22289  
29942 23589

IN NAME OF

LEWIS LIVESTOCK CO.

Surveyed July 19 1960, by R.H. Jackson  
Sept. 19 1961 by C.B. Bartlett