


T. 6N. R. 35E. W.M.

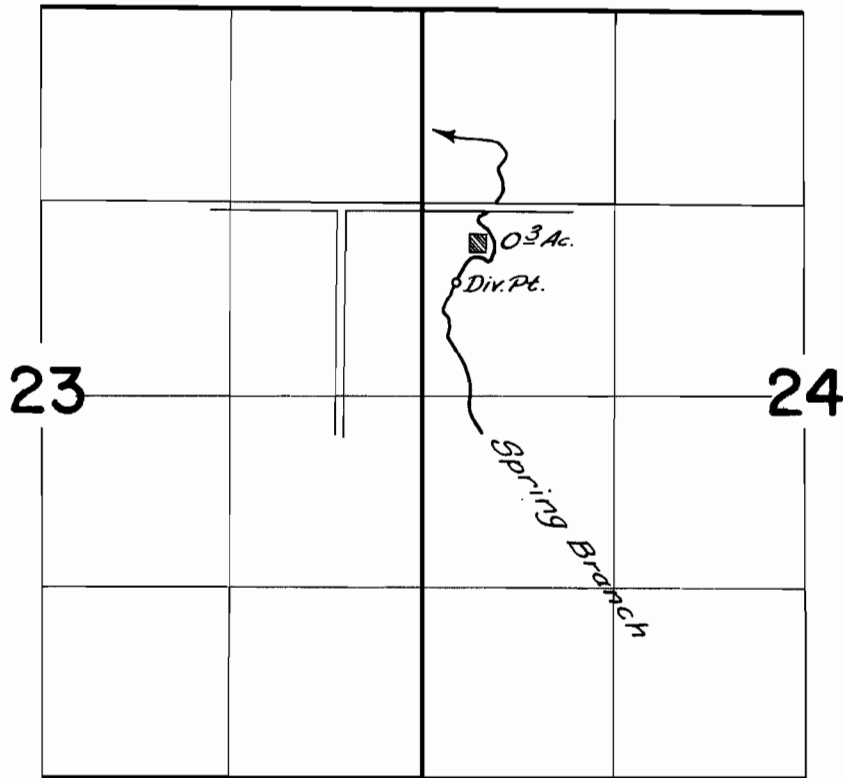

FINAL PROOF SURVEY

UNDER

Application No. 29946 Permit No. 23593

IN NAME OF

MRS. FLORENCE B. BROWN

Surveyed July 12, 1960, by M. Bish
Sept. 12, 1961 by C.O. Burtis