T. 1 N. R 15 E. W. M.

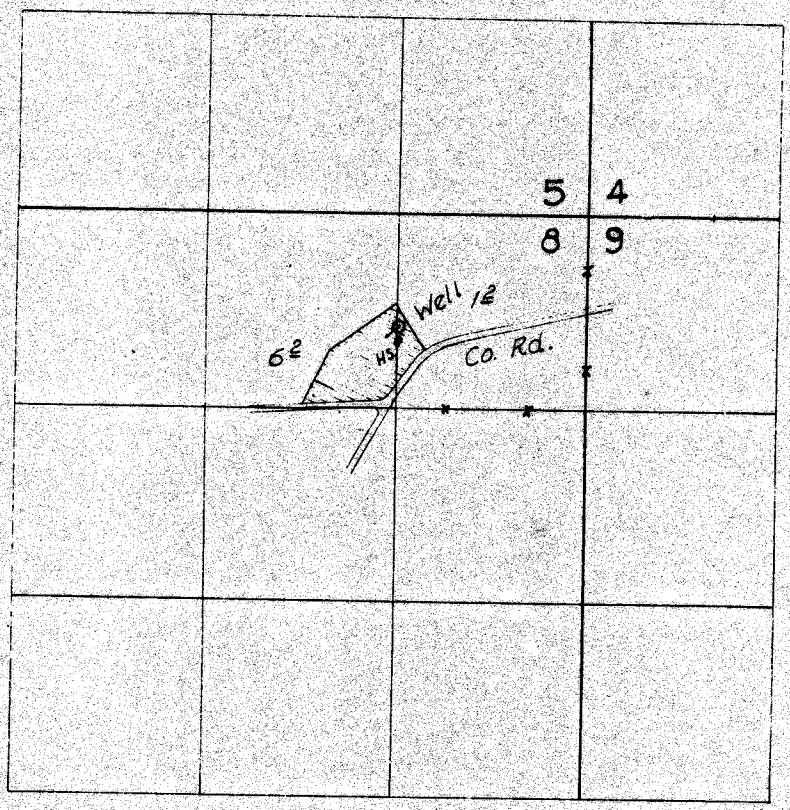

FINAL PROOF SURVEY

UNDER

Application No. G-1137 Permit No. G1048

IN NAME OF

Dr. John Shields Gilhousen

Surveyed April 10 1962, by L.W. Jeboussed

Dist. 3-1962-4