


T. 11 S. R. 5 W. W.M.

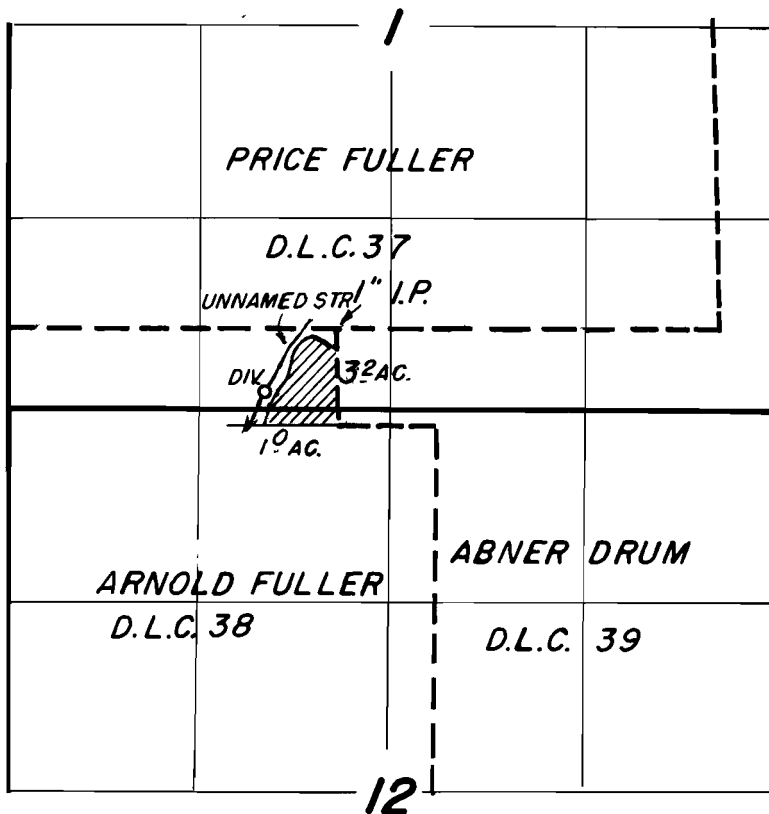

**FINAL PROOF SURVEY
UNDER**

Application No. 32663 Permit No. 25793
IN NAME OF

HAROLD JAMES JENSEN

Surveyed JULY 24 1962, by Floyd L. Sigmond