


# T. 35S. R. 11W. W.M.

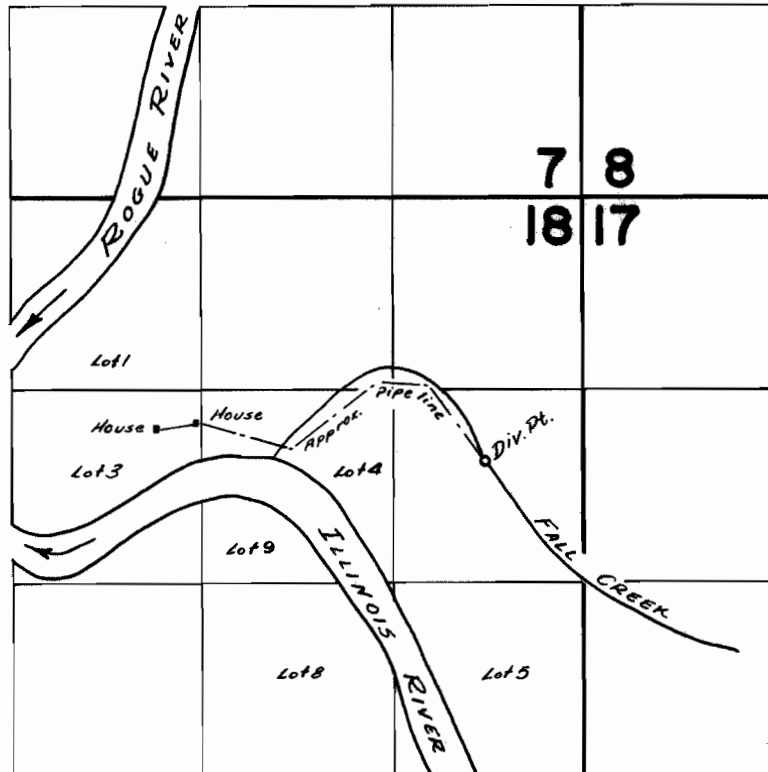

## FINAL PROOF SURVEY

UNDER

Application No. 25629 Permit No. 20230

IN NAME OF

THOMAS E. MCGINNIS

Surveyed Aug. 27. 1961., by C. Bantle