


T.35 S. R. 11 & 12 W. W. M.

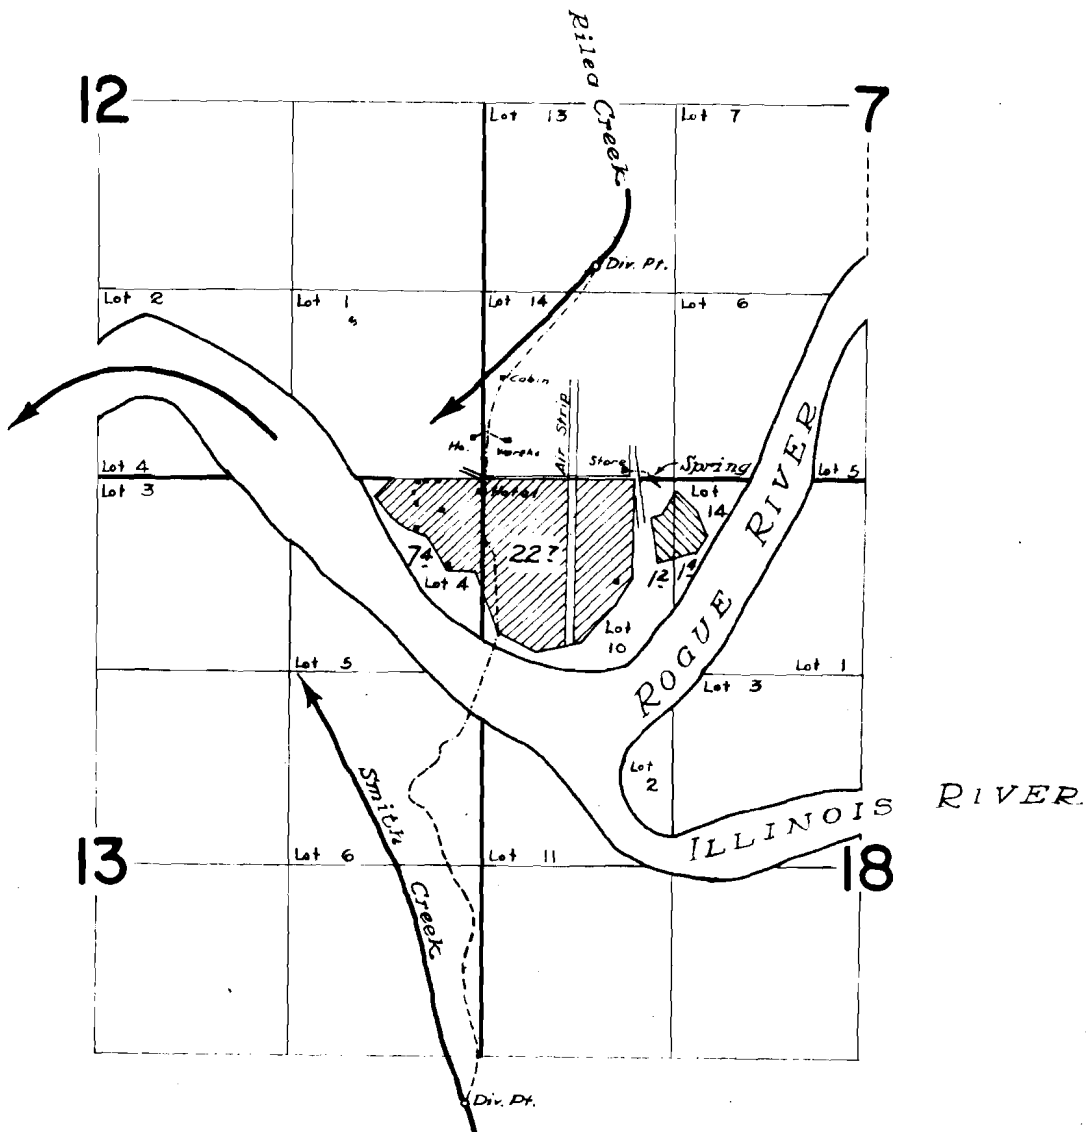

FINAL PROOF SURVEY
UNDER

-25057 19733
 28698 22596
 Application No. 30154 Permit No. 23564
 IN NAME OF

LARRY & HELEN A. LUCAS

Surveyed August 30 1961, by C.O. Bartels