


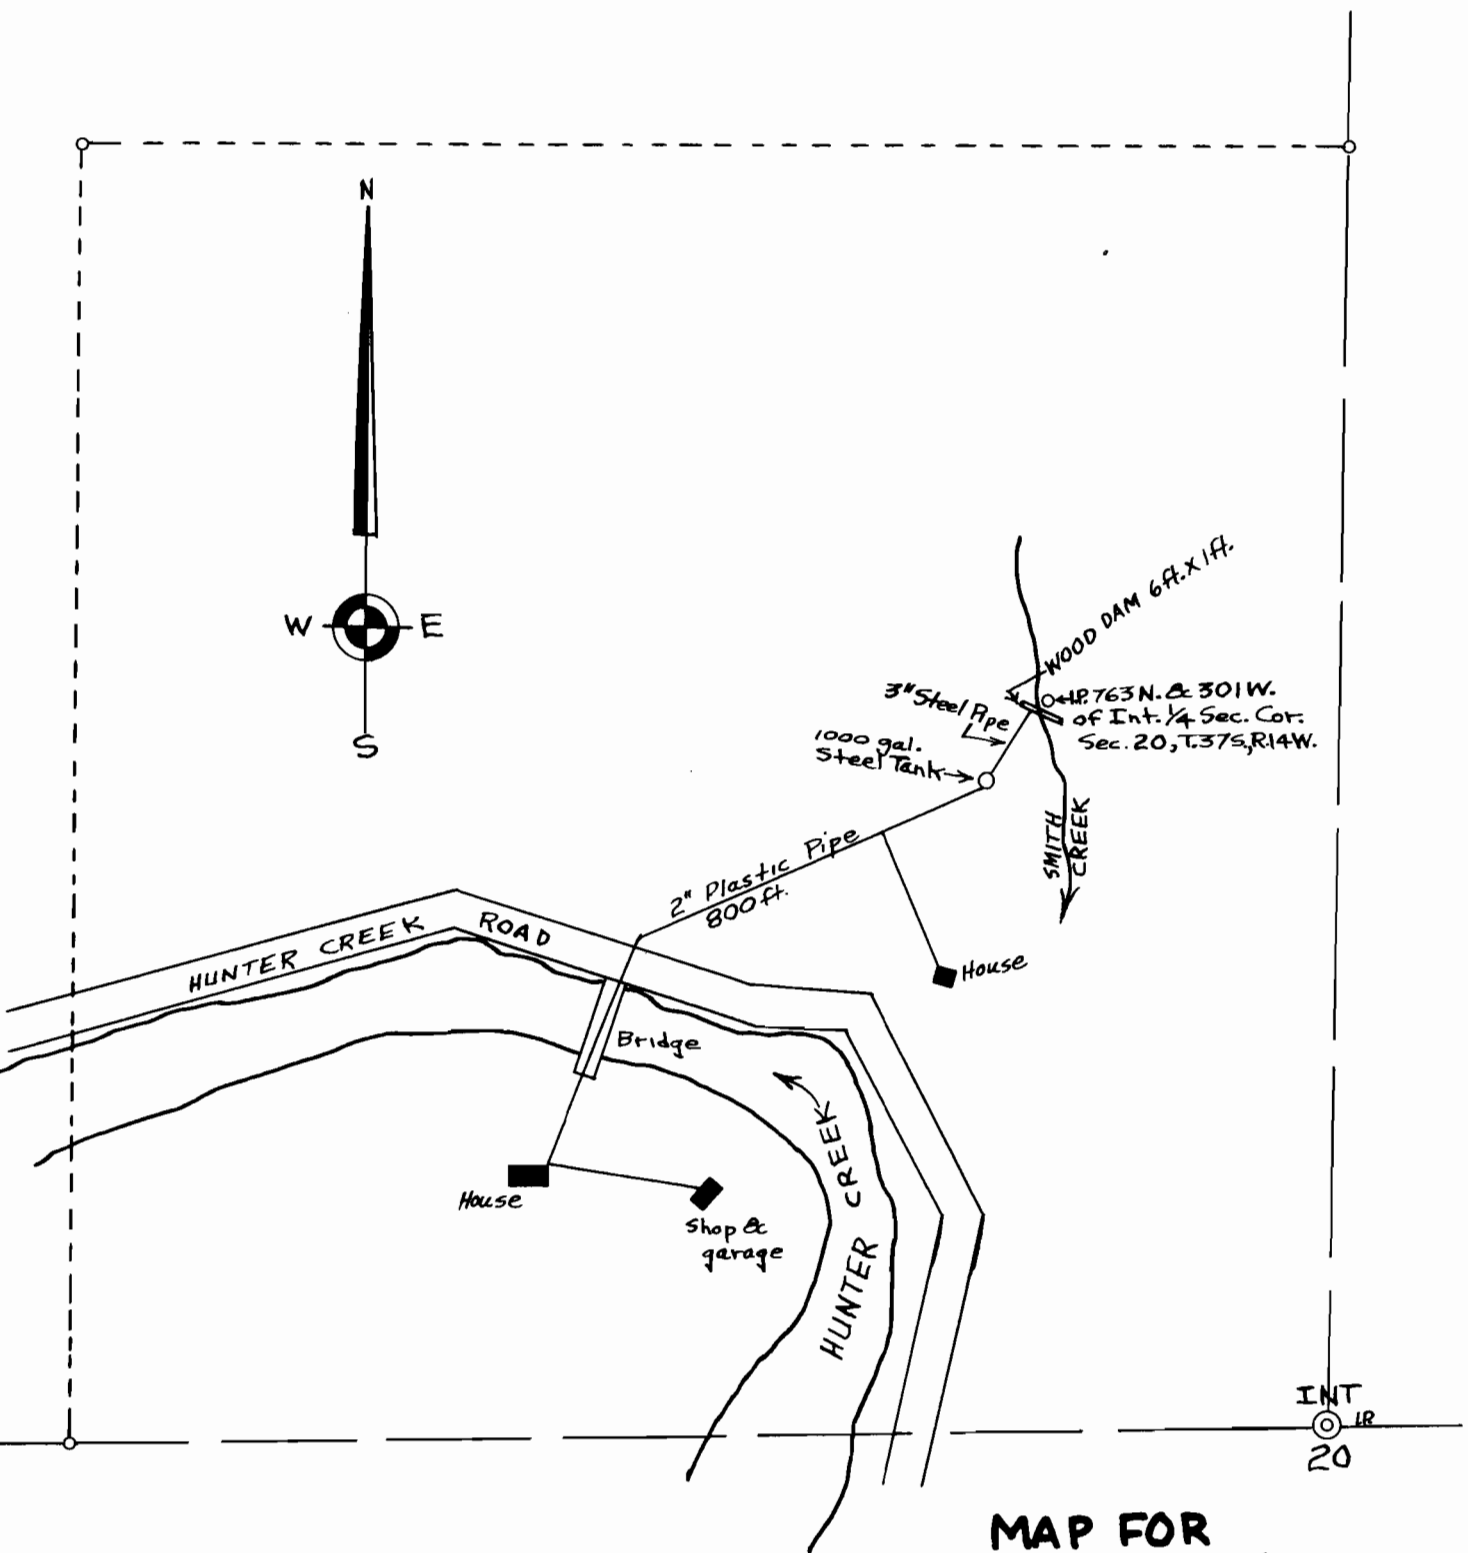

REGISTERED  
OREGON  
LAND SURVEYOR

*H. J. Newhouse*

MAY 10, 1957  
H. J. NEWHOUSE  
402

**MAP FOR  
FRED P. SMITH  
WATER FILING  
SHOWING PART OF  
SE 1/4 NW 1/4 Sec. 20, T.37S., R.14W., W.M.  
CURRY CO., ORE.**

Scale 1 in = 200 ft.  
Application No. 31876  
Permit No. 25126

Aug. 1957