


T.12S.R.2W.W.M.

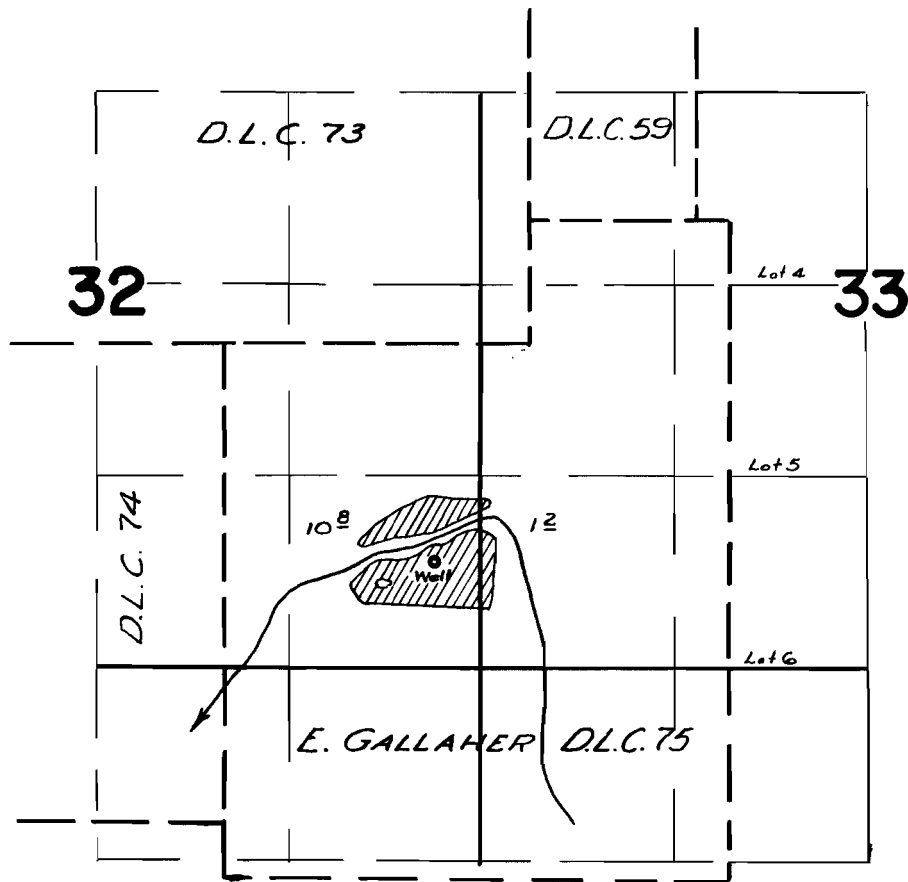

**FINAL PROOF SURVEY**  
UNDER

Application No. G-652 Permit No. G-565  
IN NAME OF

MELVIN A. & ANNA L. BLACKBURN

Surveyed 7 JUNE 1961, by M. Bish