


T.I.O.S.R. I.W.W.M.

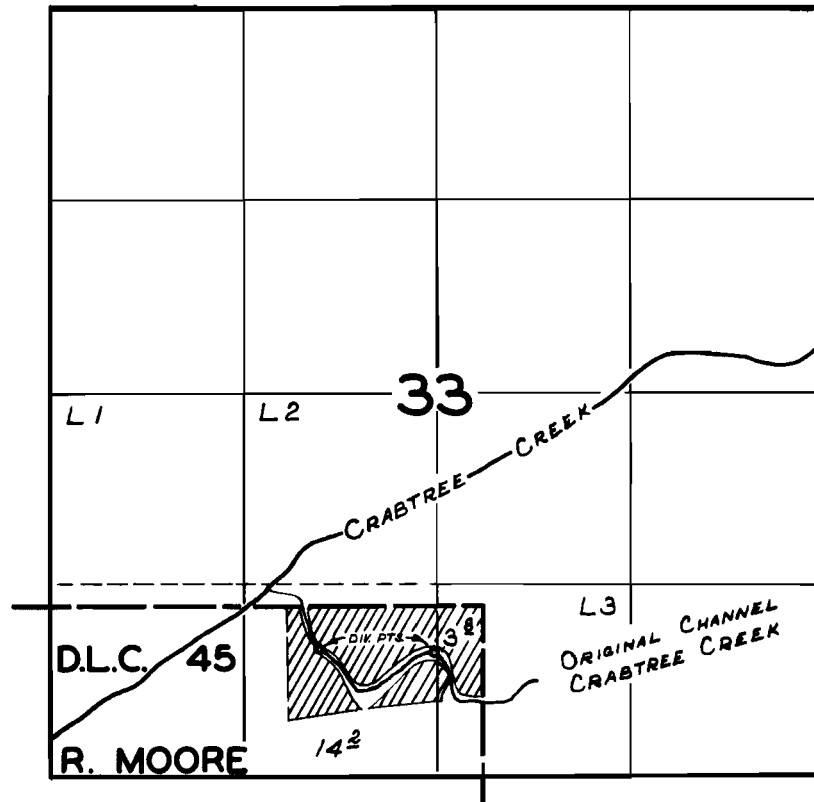

FINAL PROOF SURVEY
UNDER

Application No. **28527** Permit No. **23478**
IN NAME OF

H. K. & GEORGIA MARIE JACKSON

Surveyed **JULY 6** 1961, by **M. BISH**.....