


T.9S. R.1E.W.M.

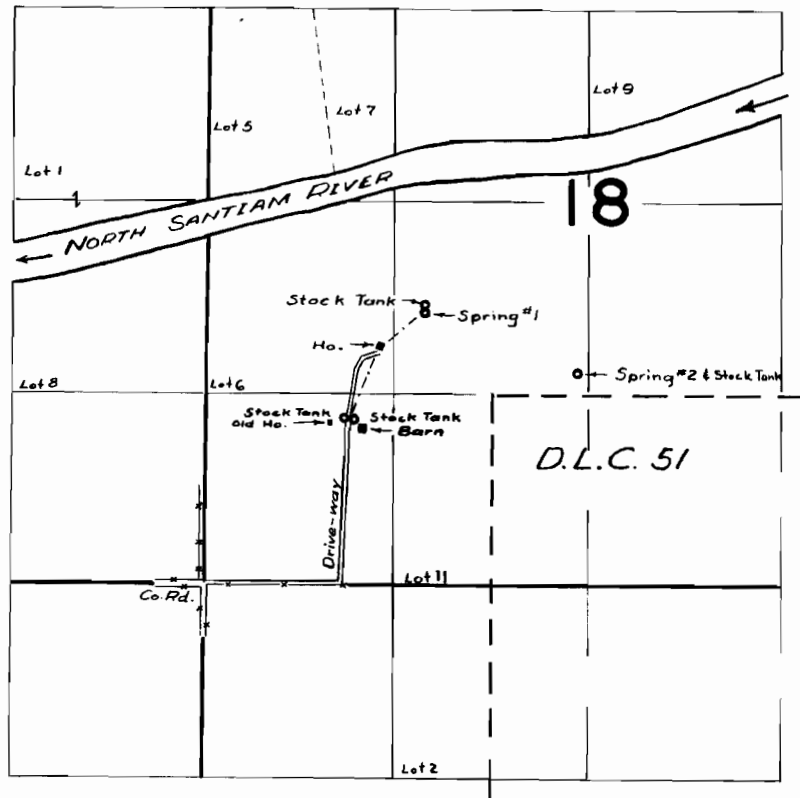

FINAL PROOF SURVEY
UNDER

Application No. 31442 Permit No. 24770
IN NAME OF

ANTON & BETTY KOCH

Surveyed 16 MAY 1961 by Mo. Bish