


T. 8 S. R. 4 W. W. M.

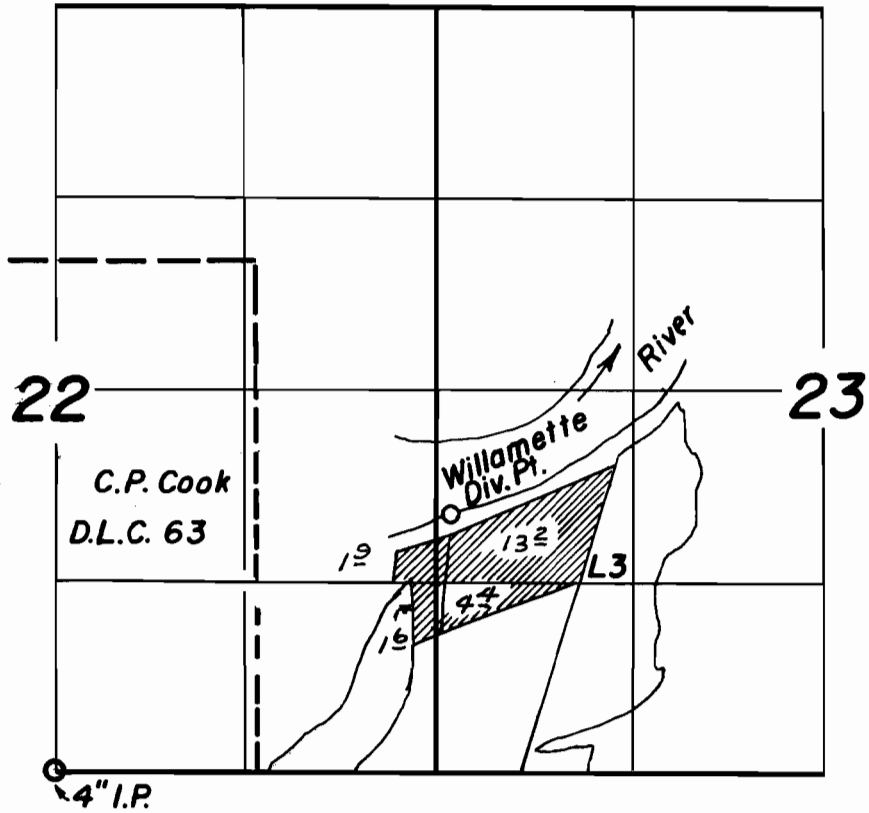

**FINAL PROOF SURVEY**  
UNDER

Application No. 32122... Permit No. 25343.  
IN NAME OF

**Agnes Hoyser**

Surveyed JULY 13 1962, by Floyd L. Sigmund