


T. 9 S. R. 2 E. W. M.

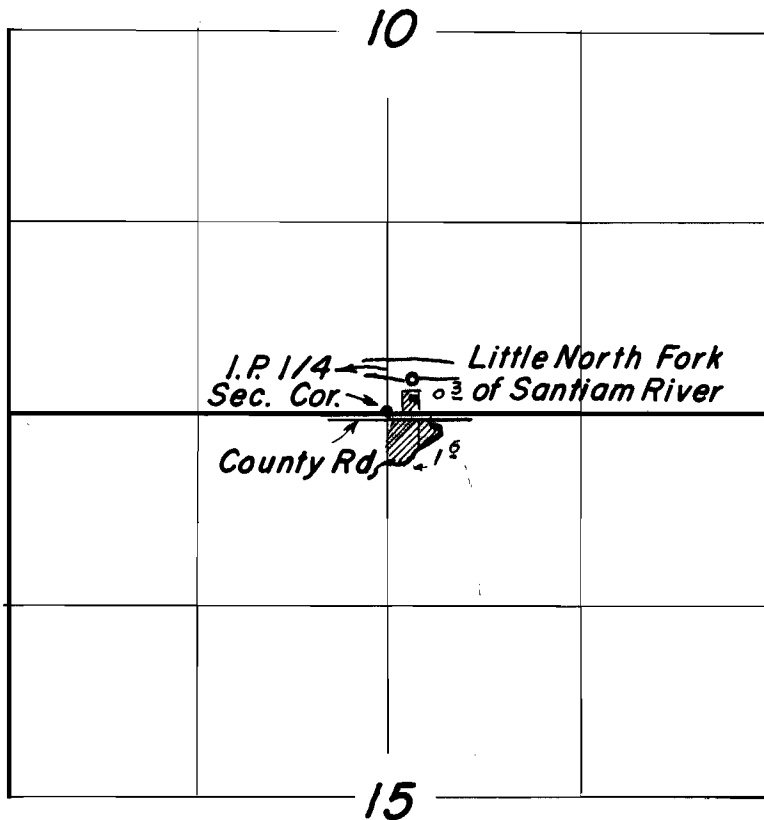

**FINAL PROOF SURVEY**  
UNDER

Application No. 32977 Permit No. 26079  
IN NAME OF

C.L. & Fannie P. Bowes

Surveyed June 21 1962, by Floyd L. Sigmond