


25440
30195

T.2S. R.23E.

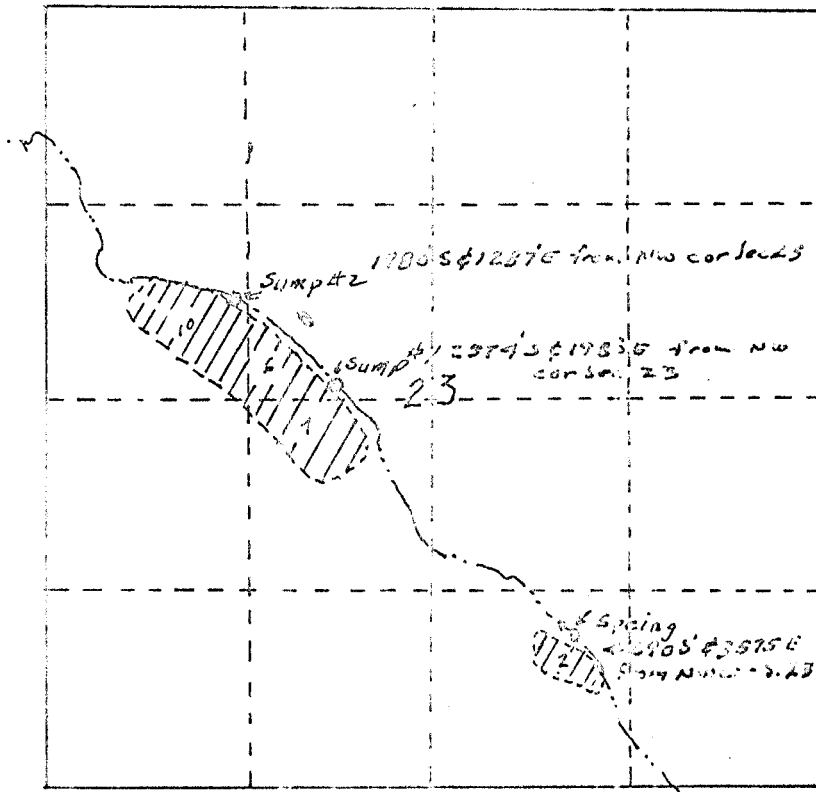

SPRINKLER
APPLICATION
for
McELIGOTT Bros.

Application No. 32250
Permit No. 25440