


25781
30196

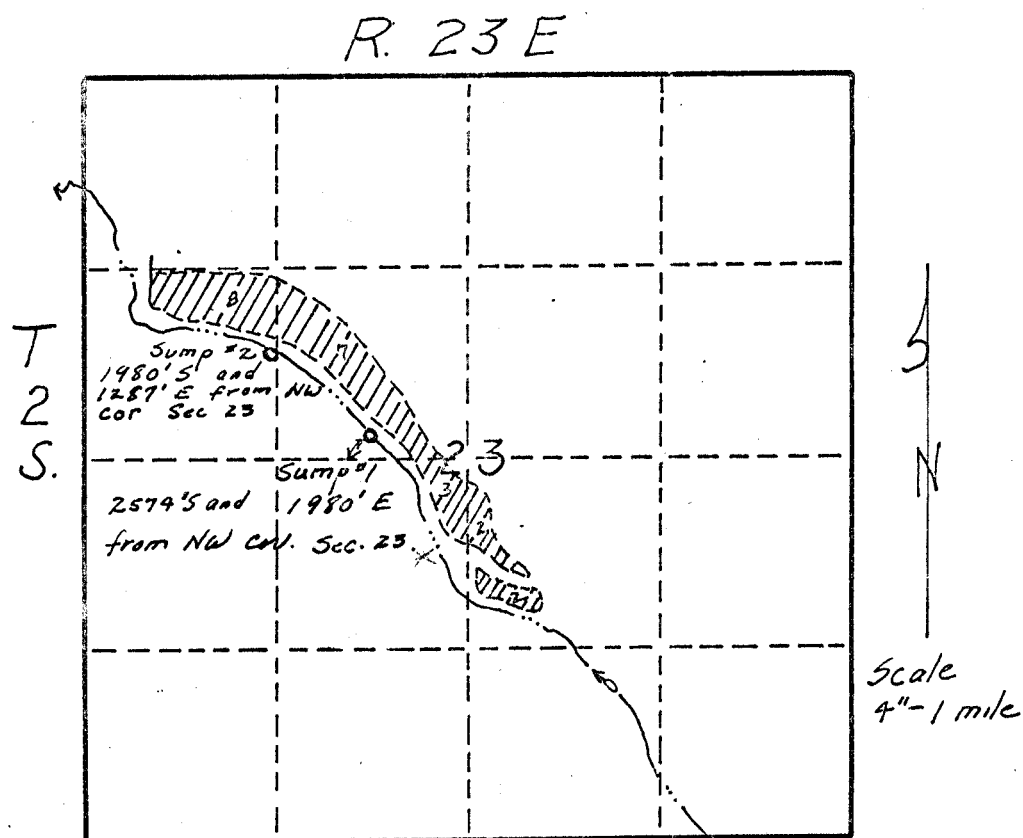

**McELGOTT BROS.
SPRINKLER APPLICATION**

Application No. 32605
Permit No. 25781